


TOTAL SF AVAILABLE - 1,051 RSF(12%)

[Click to access 3D model](#)

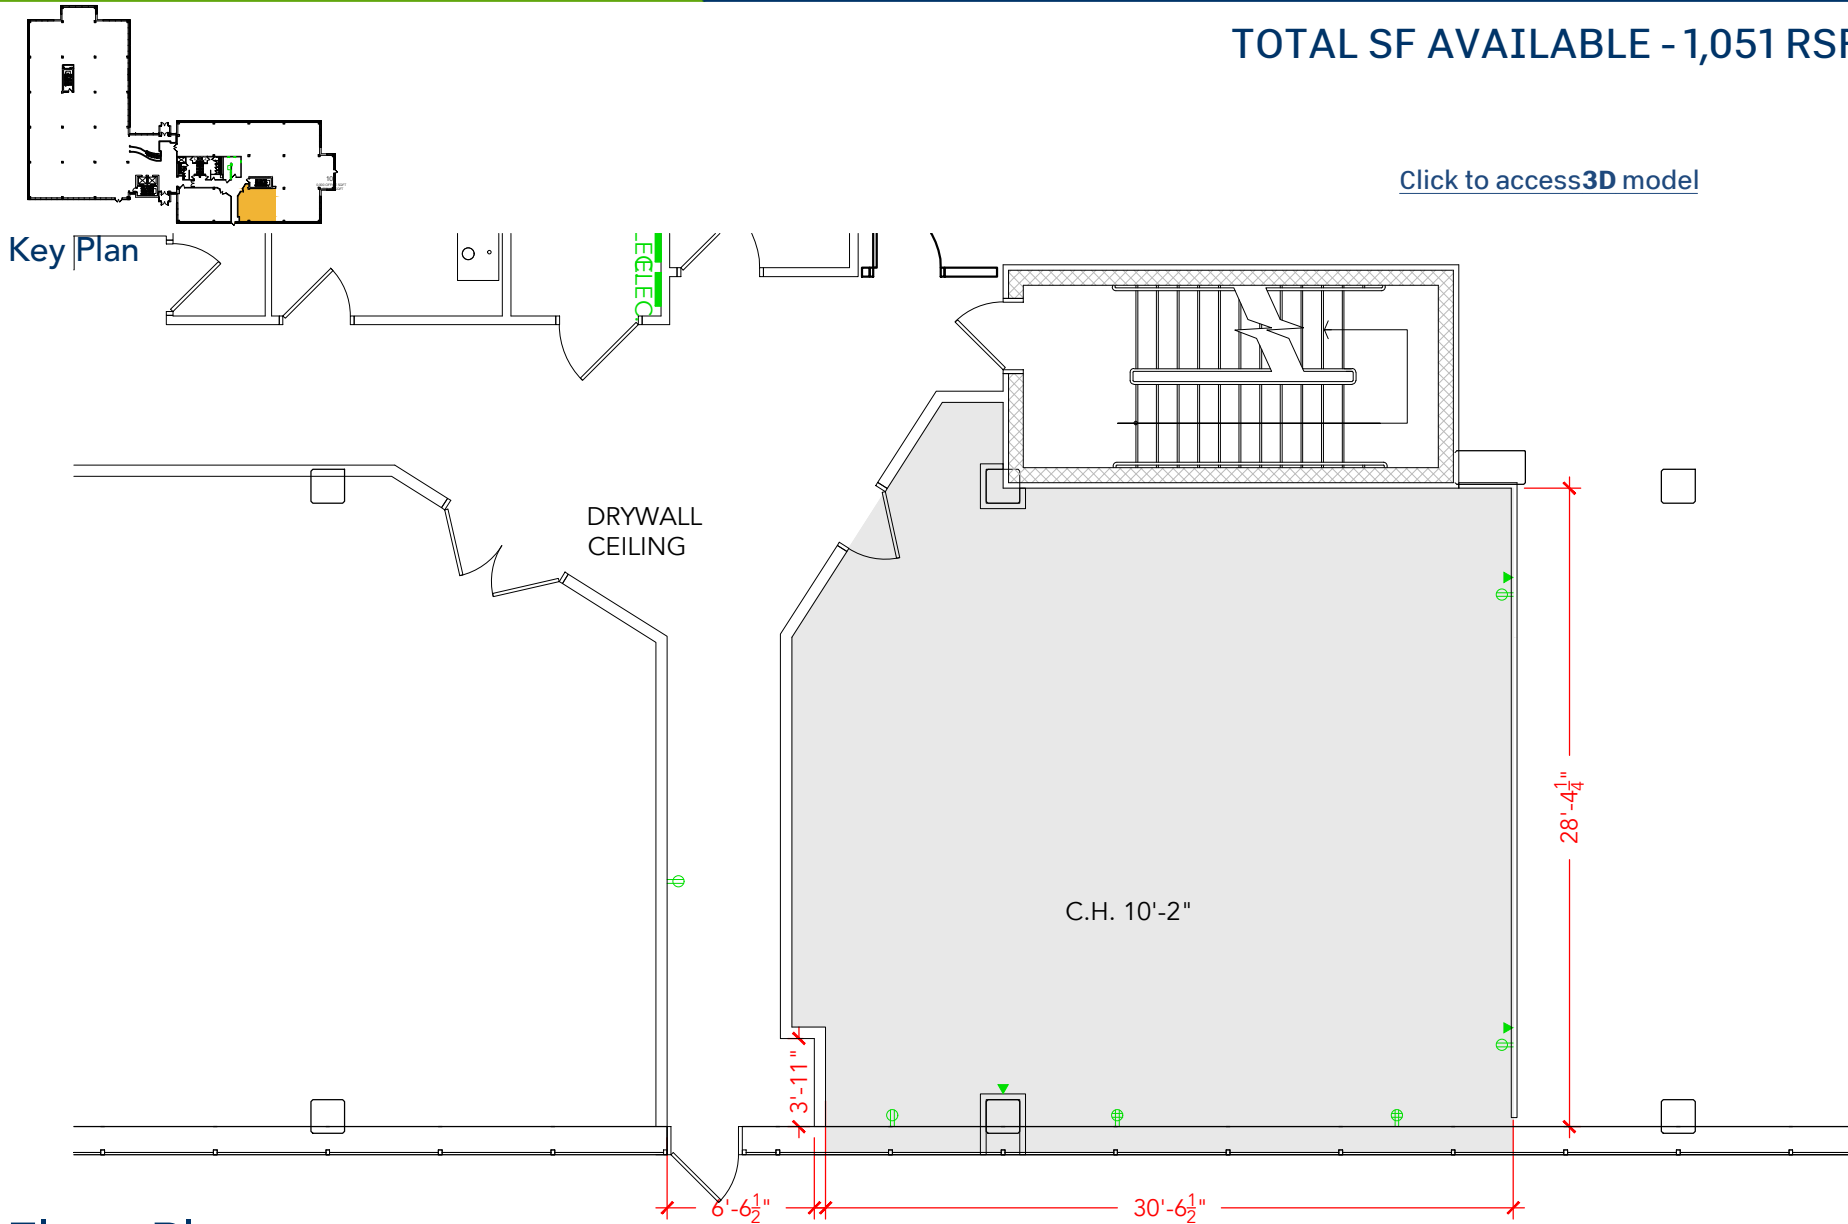

Floor Plan