



SUITE 250-290
10,692 RSF(16%)
TOTAL SQUARE FEET

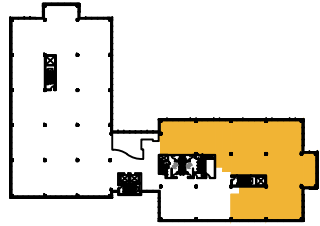

Key Plan

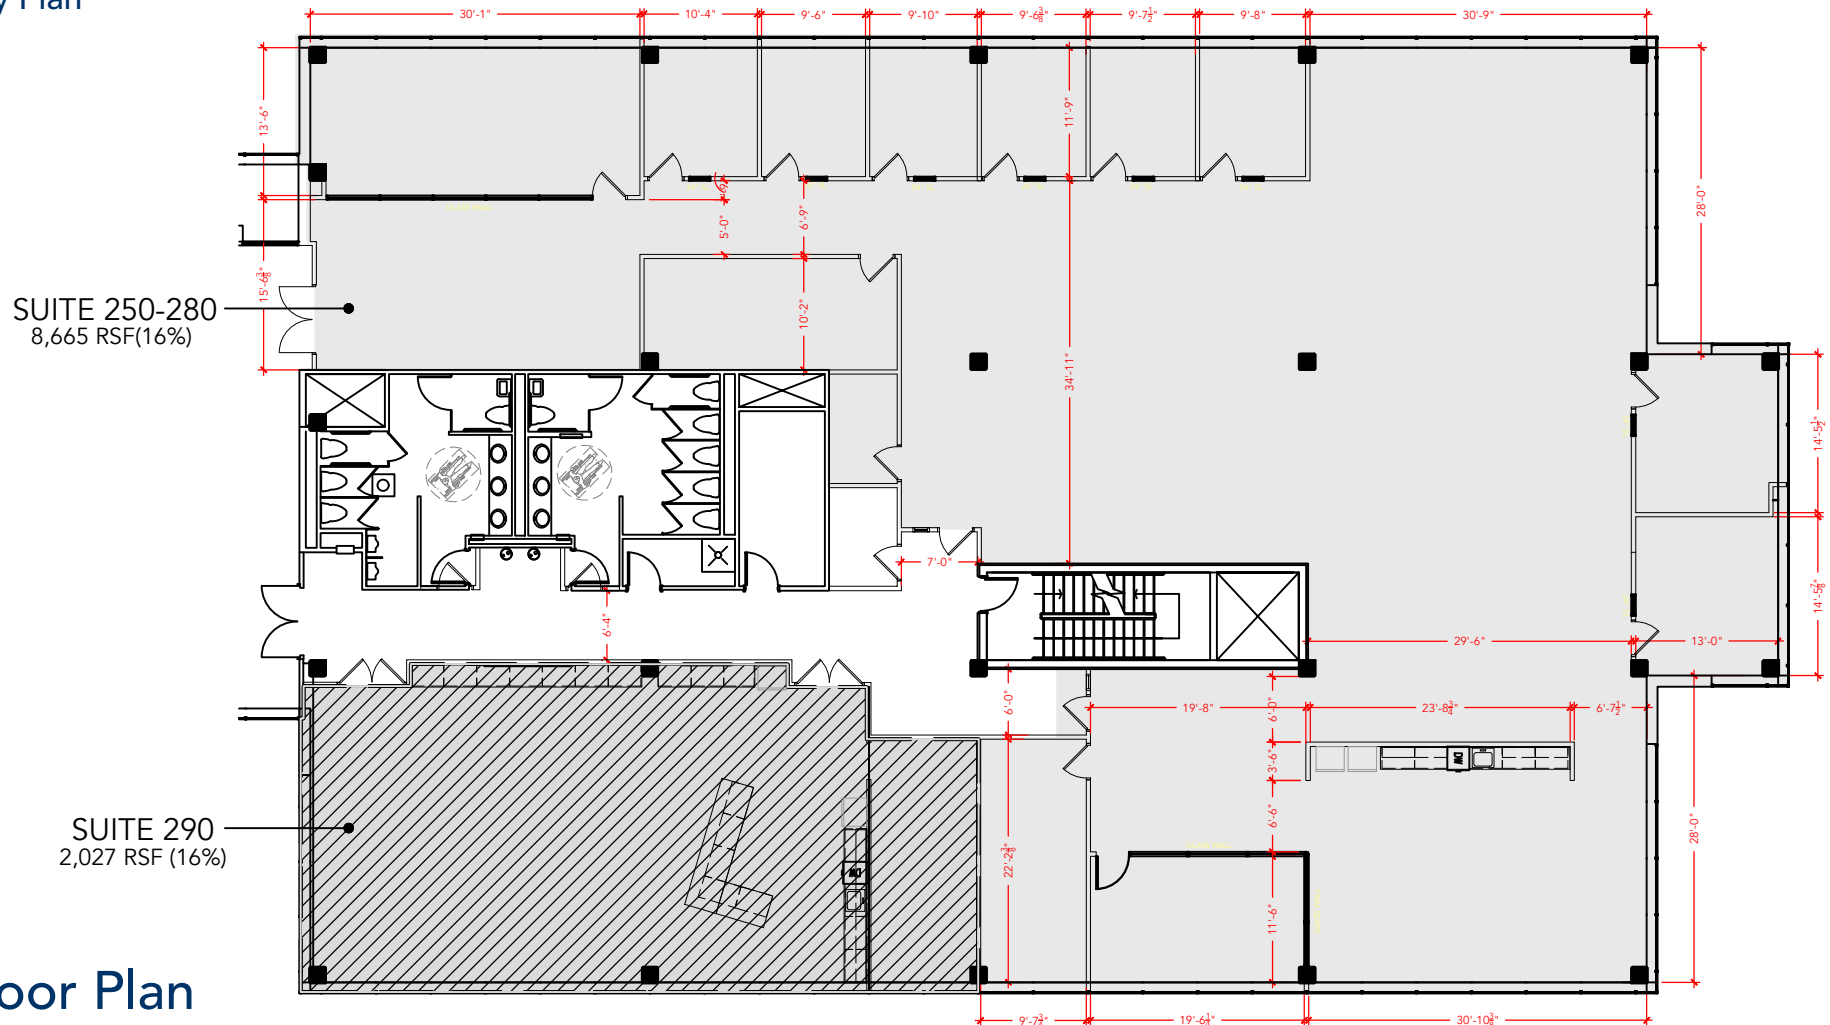

Floor Plan