
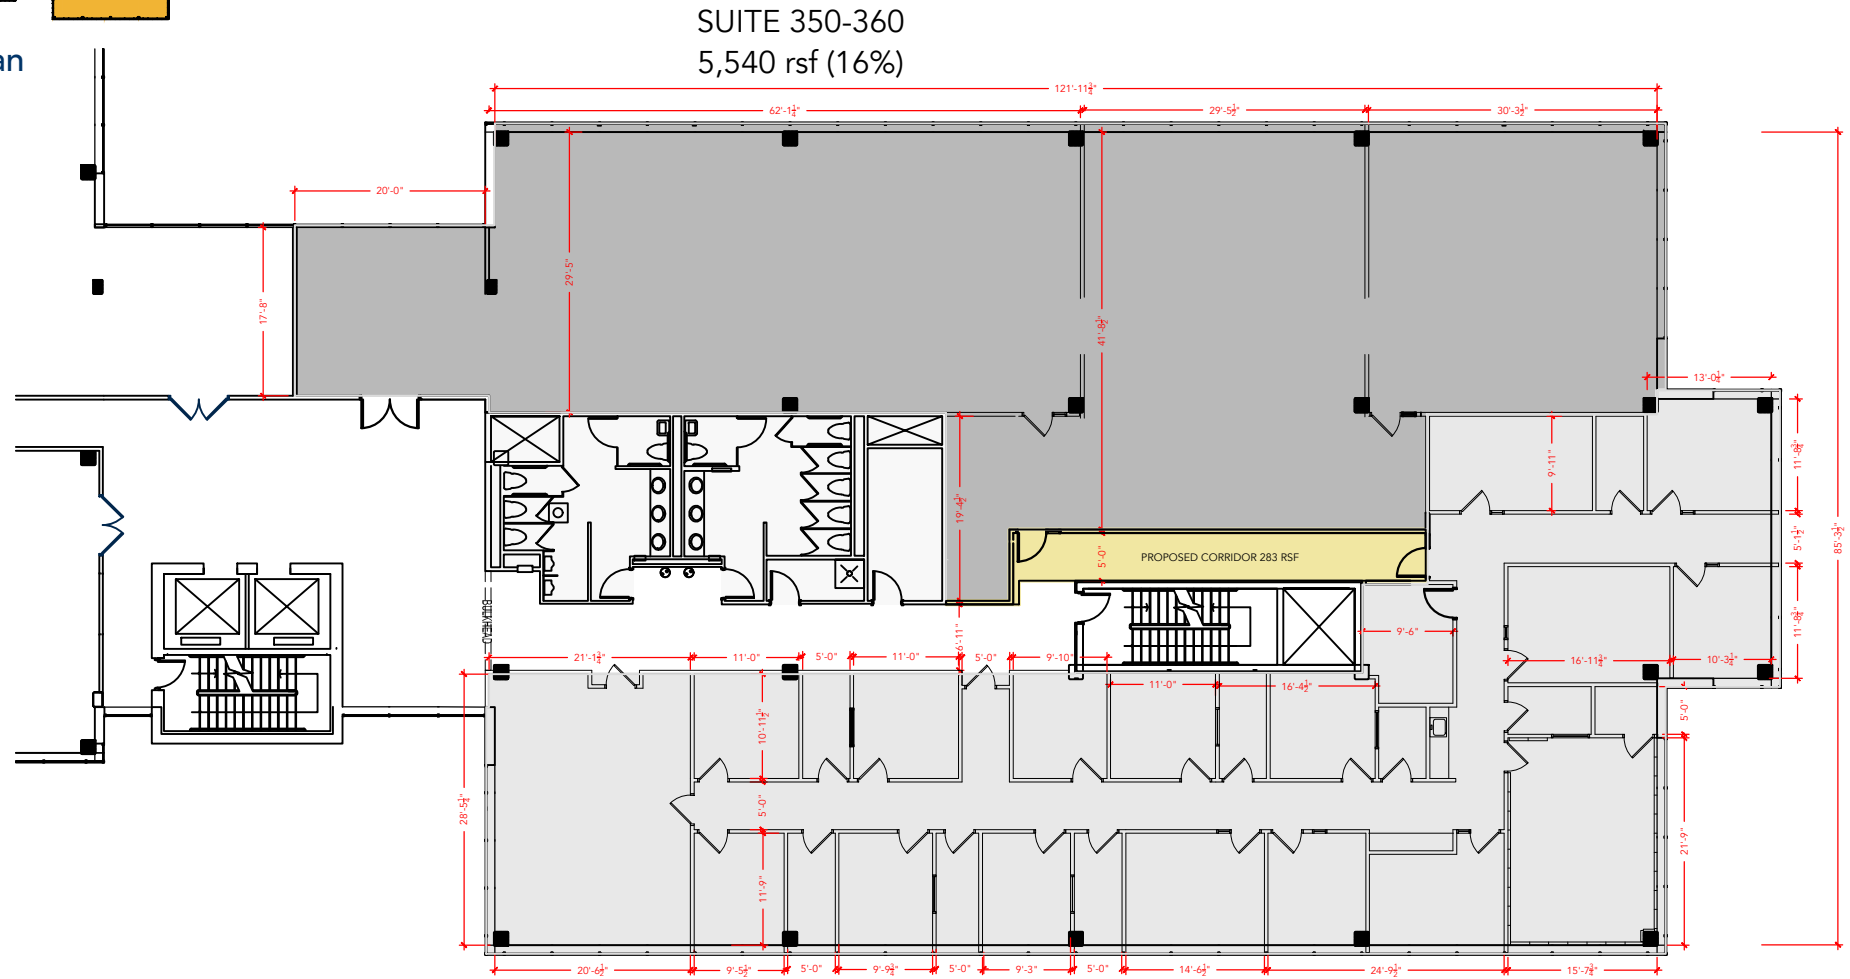


TOTAL SF AVAILABLE - 5,540 RSF(16%)

Key Plan

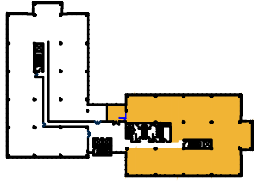

Floor Plan

SUITE 370-390
5,518 rsf (16%)