



TOTAL SF AVAILABLE -11,477 RSF (16%)

[Click to access 3D model](#)

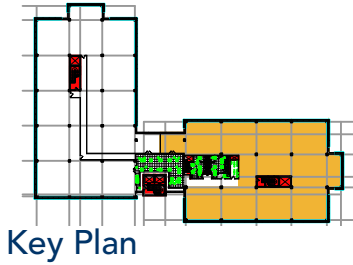

SUITE 350-360
5,348 RSF (16%)

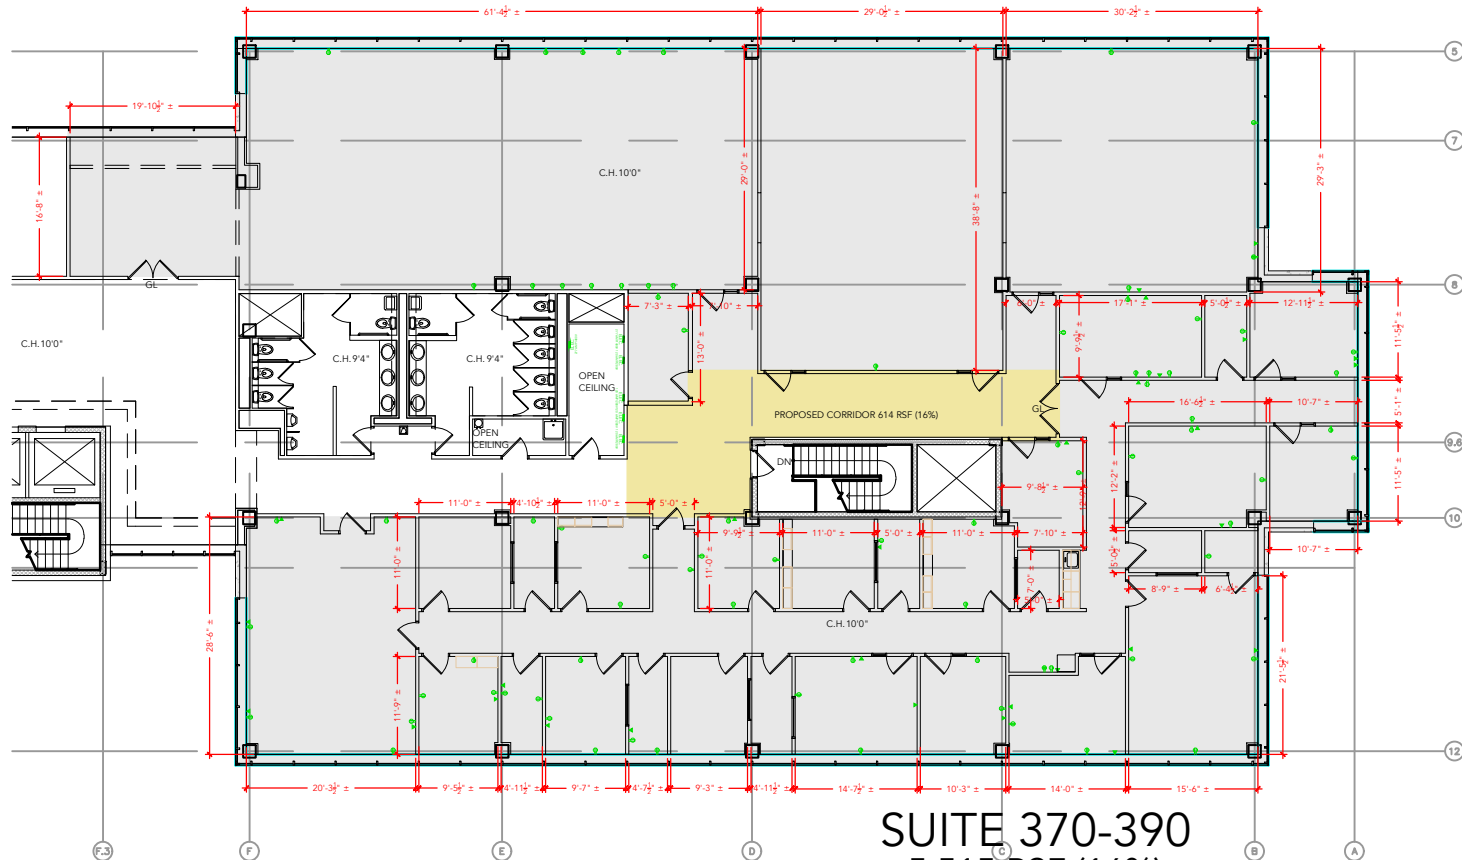

Floor Plan