
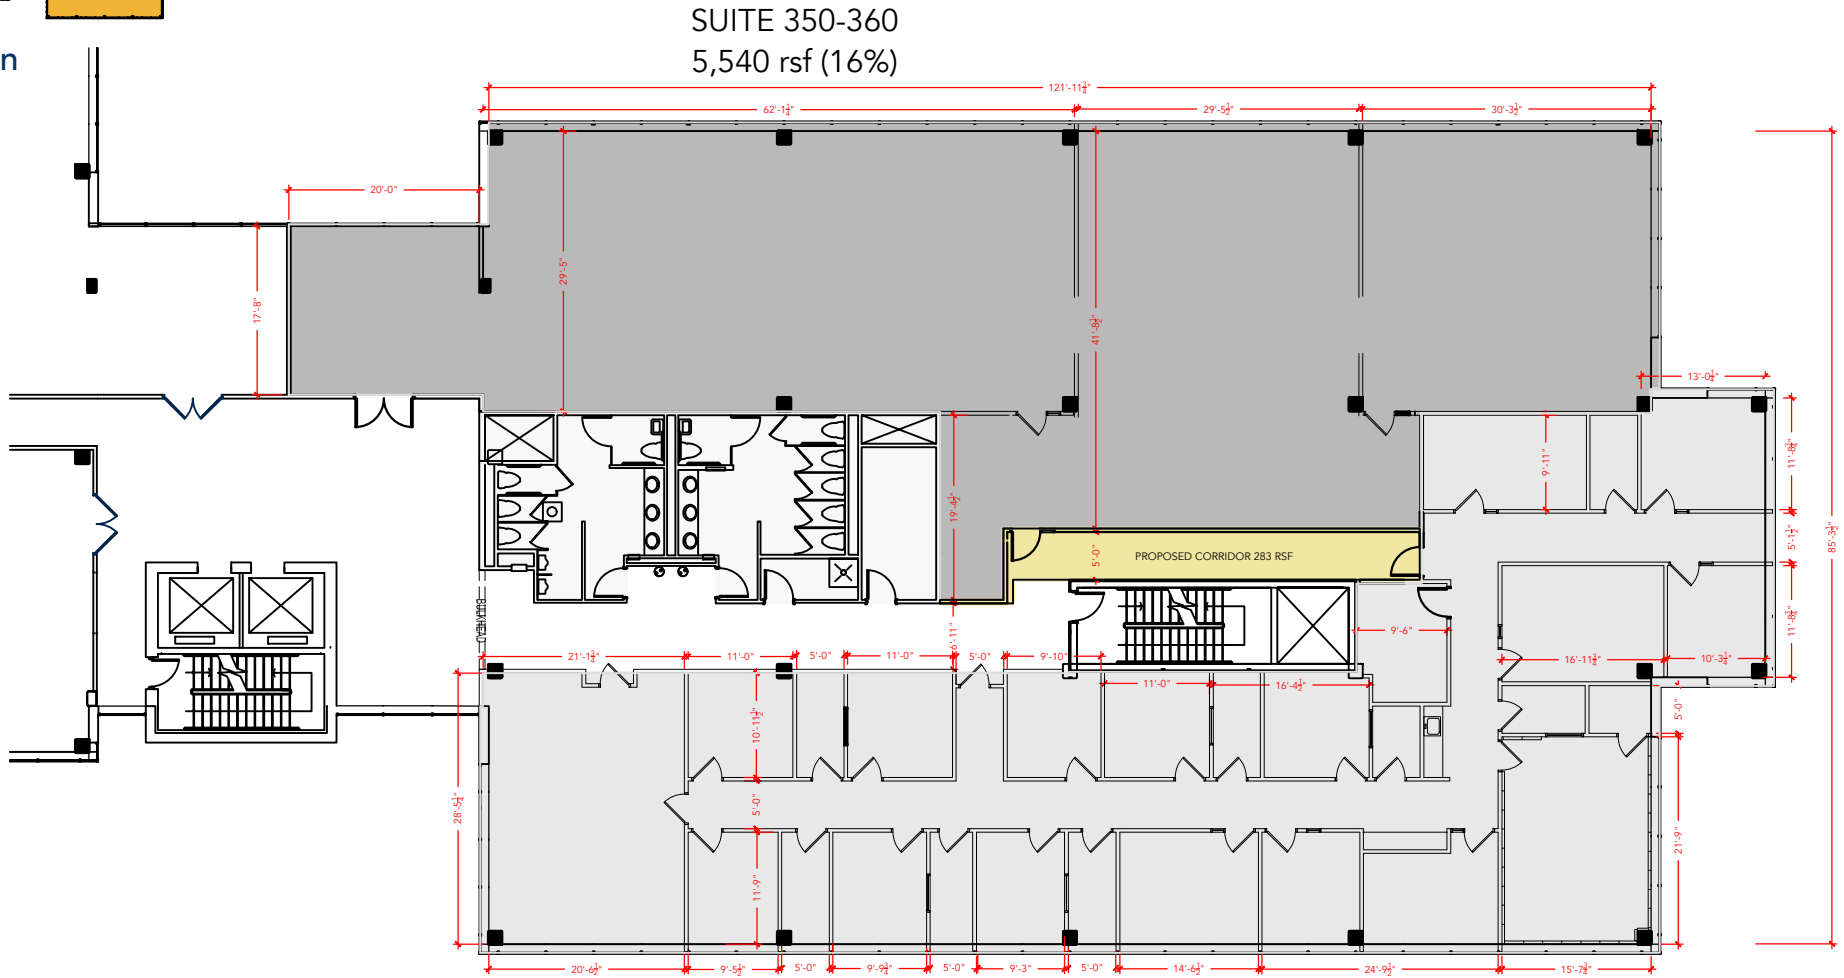


TOTAL SF AVAILABLE - 5,518 RSF(16%)

Key Plan

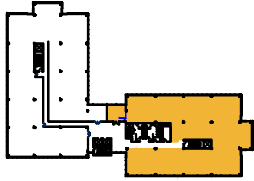

Floor Plan

SUITE 350-360
5,540 rsf (16%)

SUITE 370-390
5,518 rsf (16%)