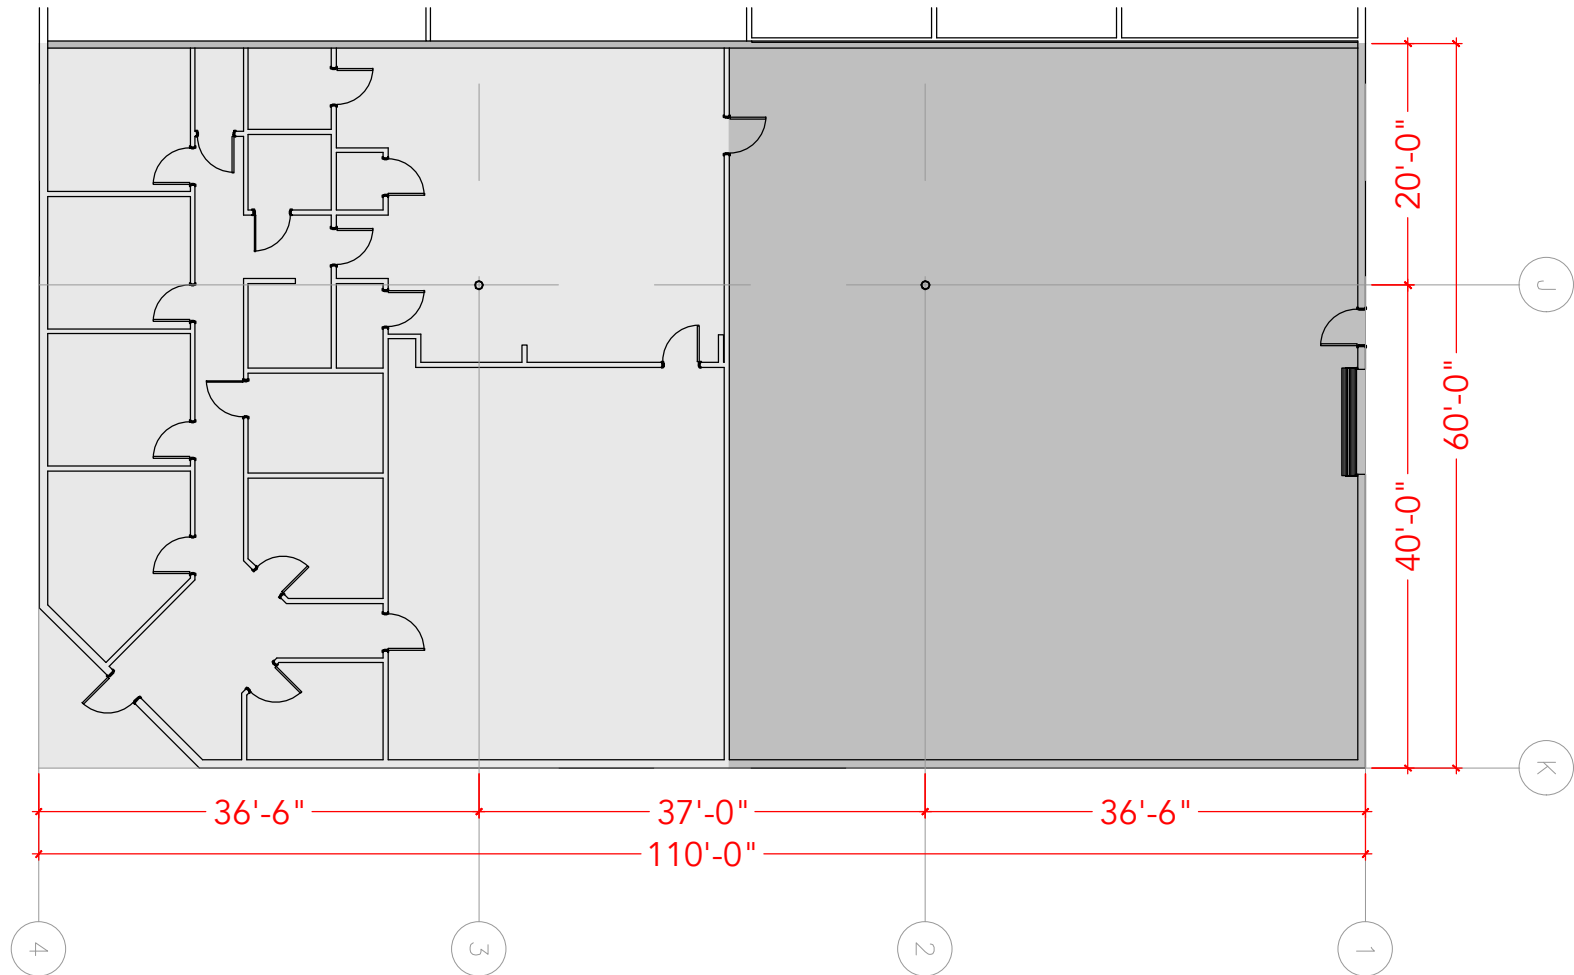
**TOTAL SF AVAILABLE -6,600 SF**

OFFICE - 3,435 SF

WAREHOUSE - 3,165 SF

[Click to access CADD file](#)**Key Plan****Floor Plan**