


Key Plan

TOTAL AVAILABLE - 28,060 RSF

OFFICE - 11,063 RSF
WAREHOUSE - 16,997 RSF

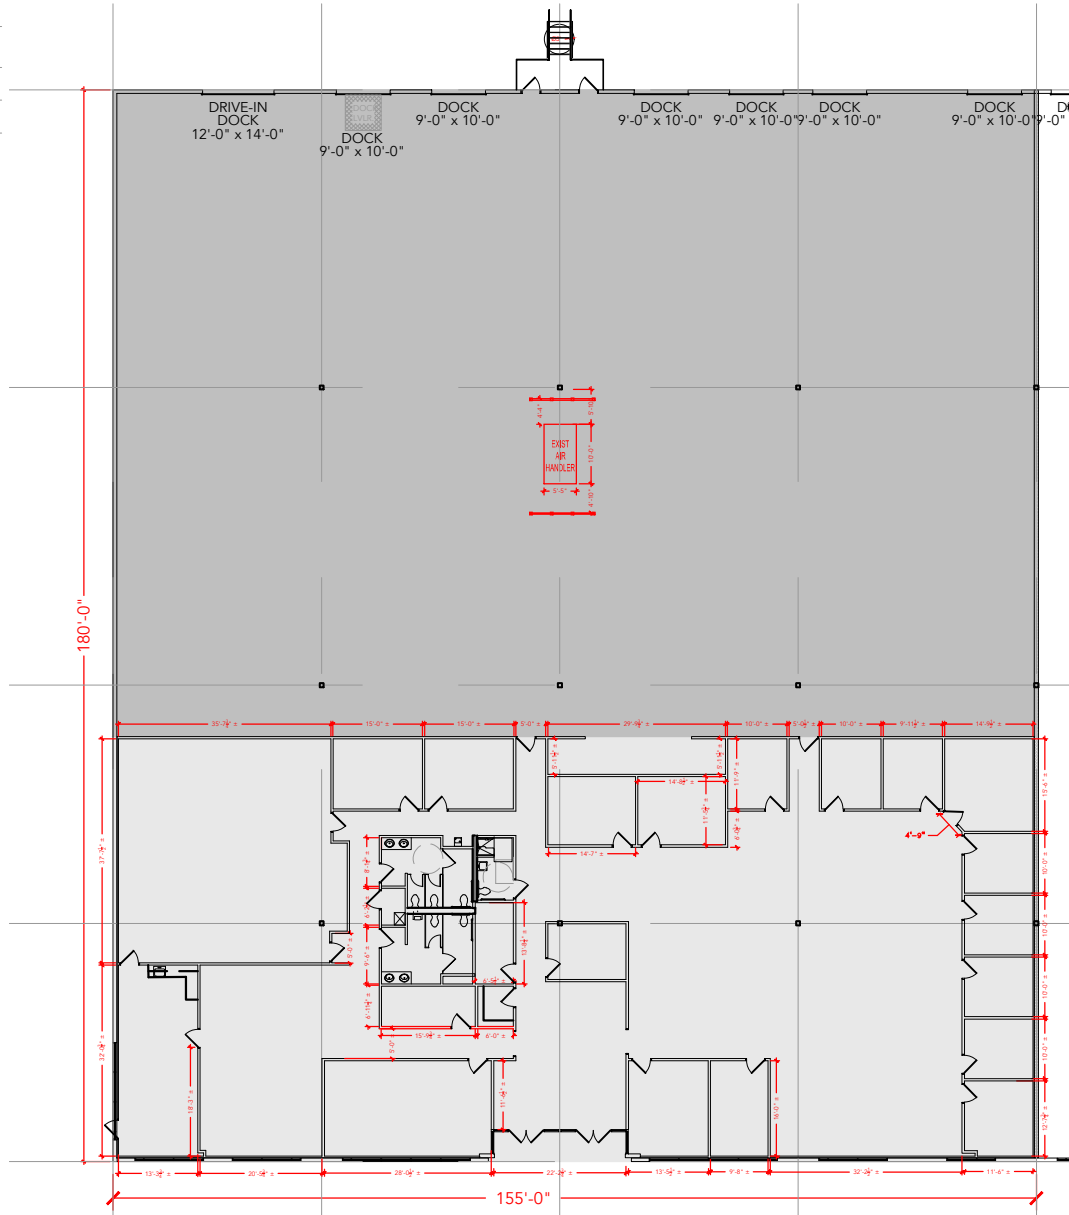

Floor Plan