



TOTAL SF AVAILABLE -16,760 SF

OFFICE - 706 SF

WAREHOUSE - 16,054 SF

[Click to access CADD file](#)

Key Plan

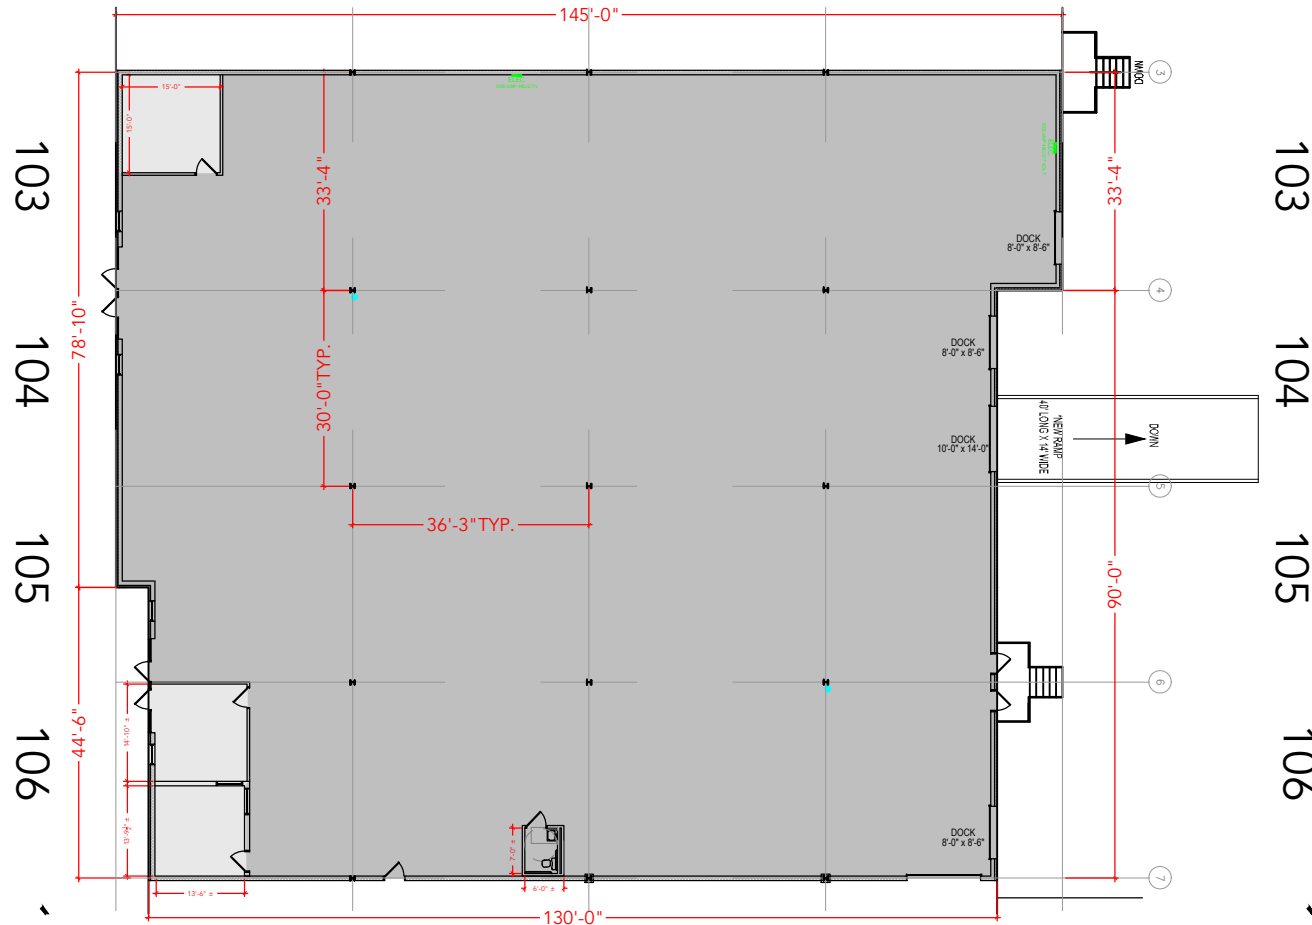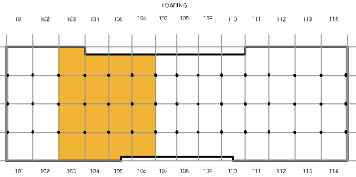

Floor Plan