


**TOTAL SF AVAILABLE -57,508 SF**


OFFICE - 0,000 SF

WAREHOUSE - 57,508 SF

[Click to access CADD file](#)

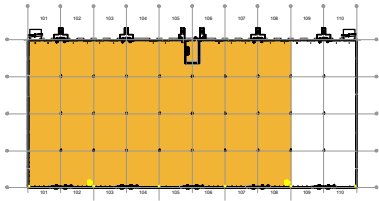

Key Plan

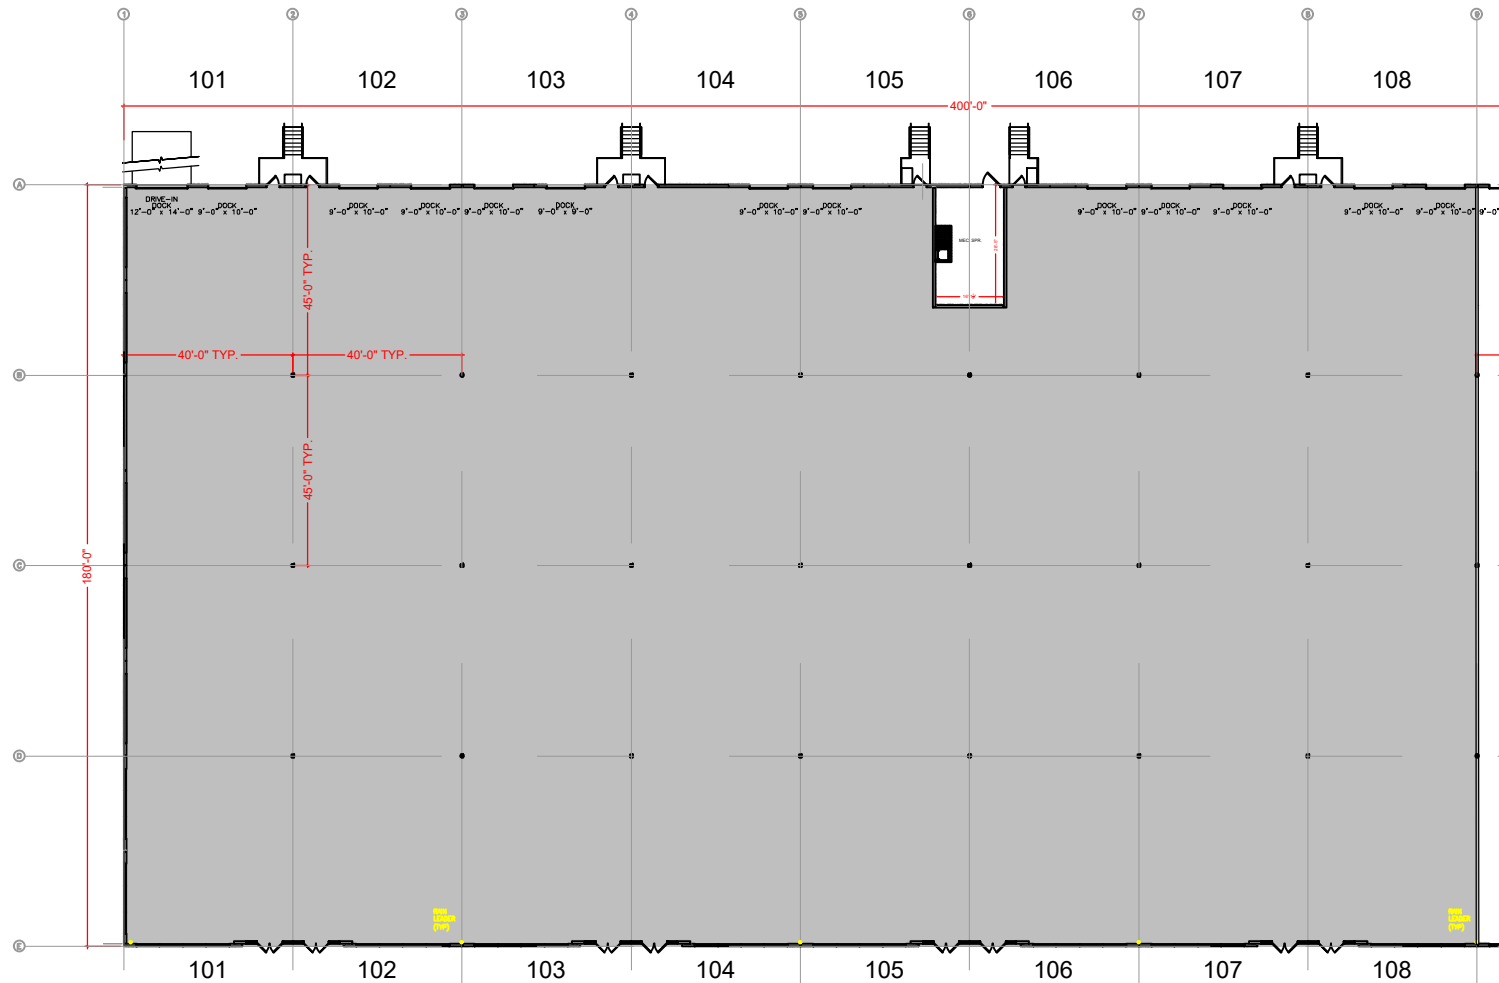

Floor Plan