


TOTAL SF AVAILABLE -11,242 RSF

OFFICE - 0,000 SF

WAREHOUSE SF - 11,242 RSF

* INCLUDES % OF METER ROOM
[Click to access 3D model](#)

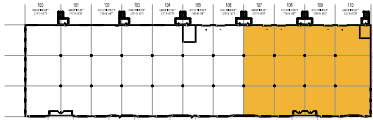

Key Plan



Floor Plan