


TOTAL SF AVAILABLE -27,149 RSF

OFFICE - 0,0000 RSF


WAREHOUSE - 27,149 RSF

* INCLUDES % OF METER ROOM

[Click to access CADD file](#)

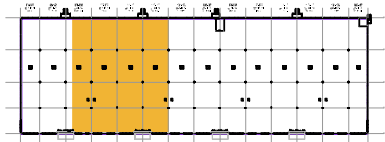

Key Plan

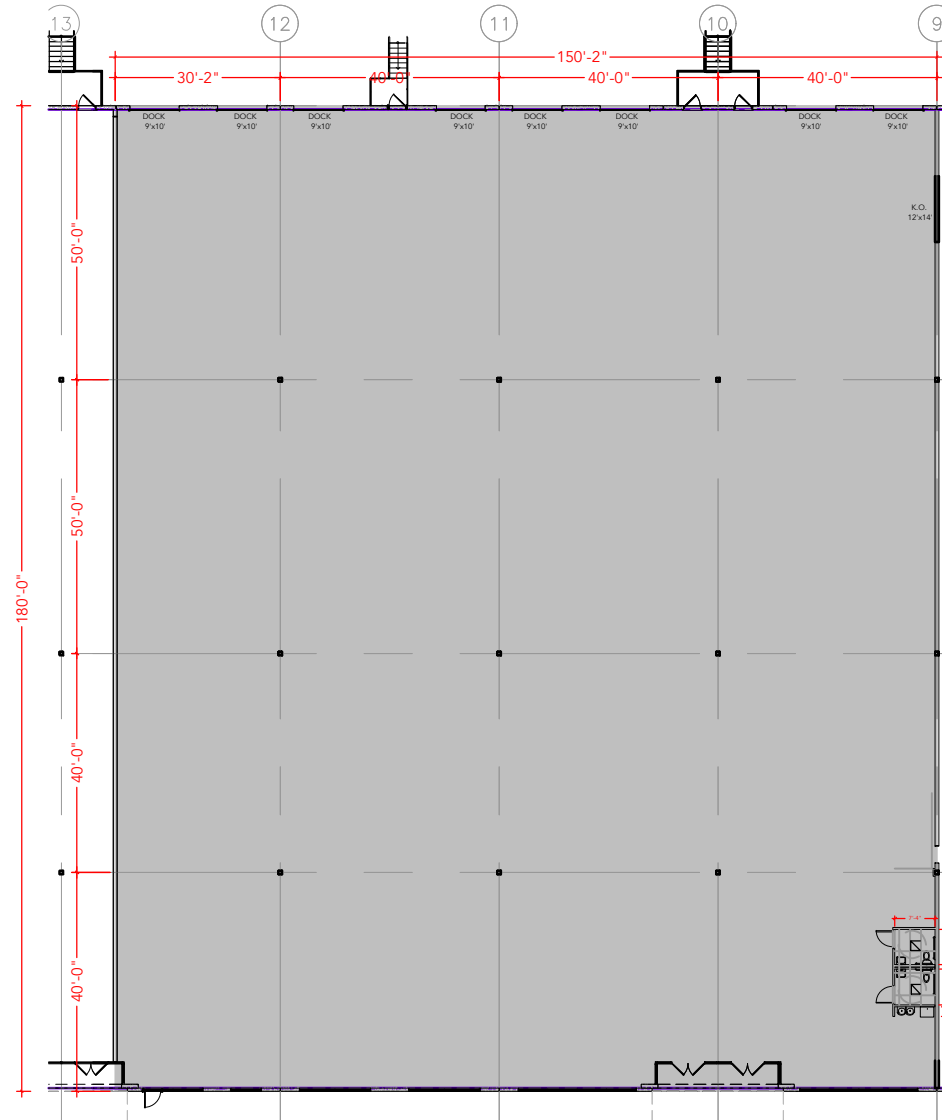

Floor Plan