



**TOTAL SF AVAILABLE - 97,200 SF**

OFFICE - 0,000 SF  
WAREHOUSE - 97,200 SF

[Click to access 3D model](#)

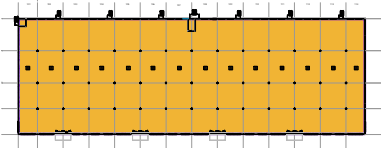

## Key Plan

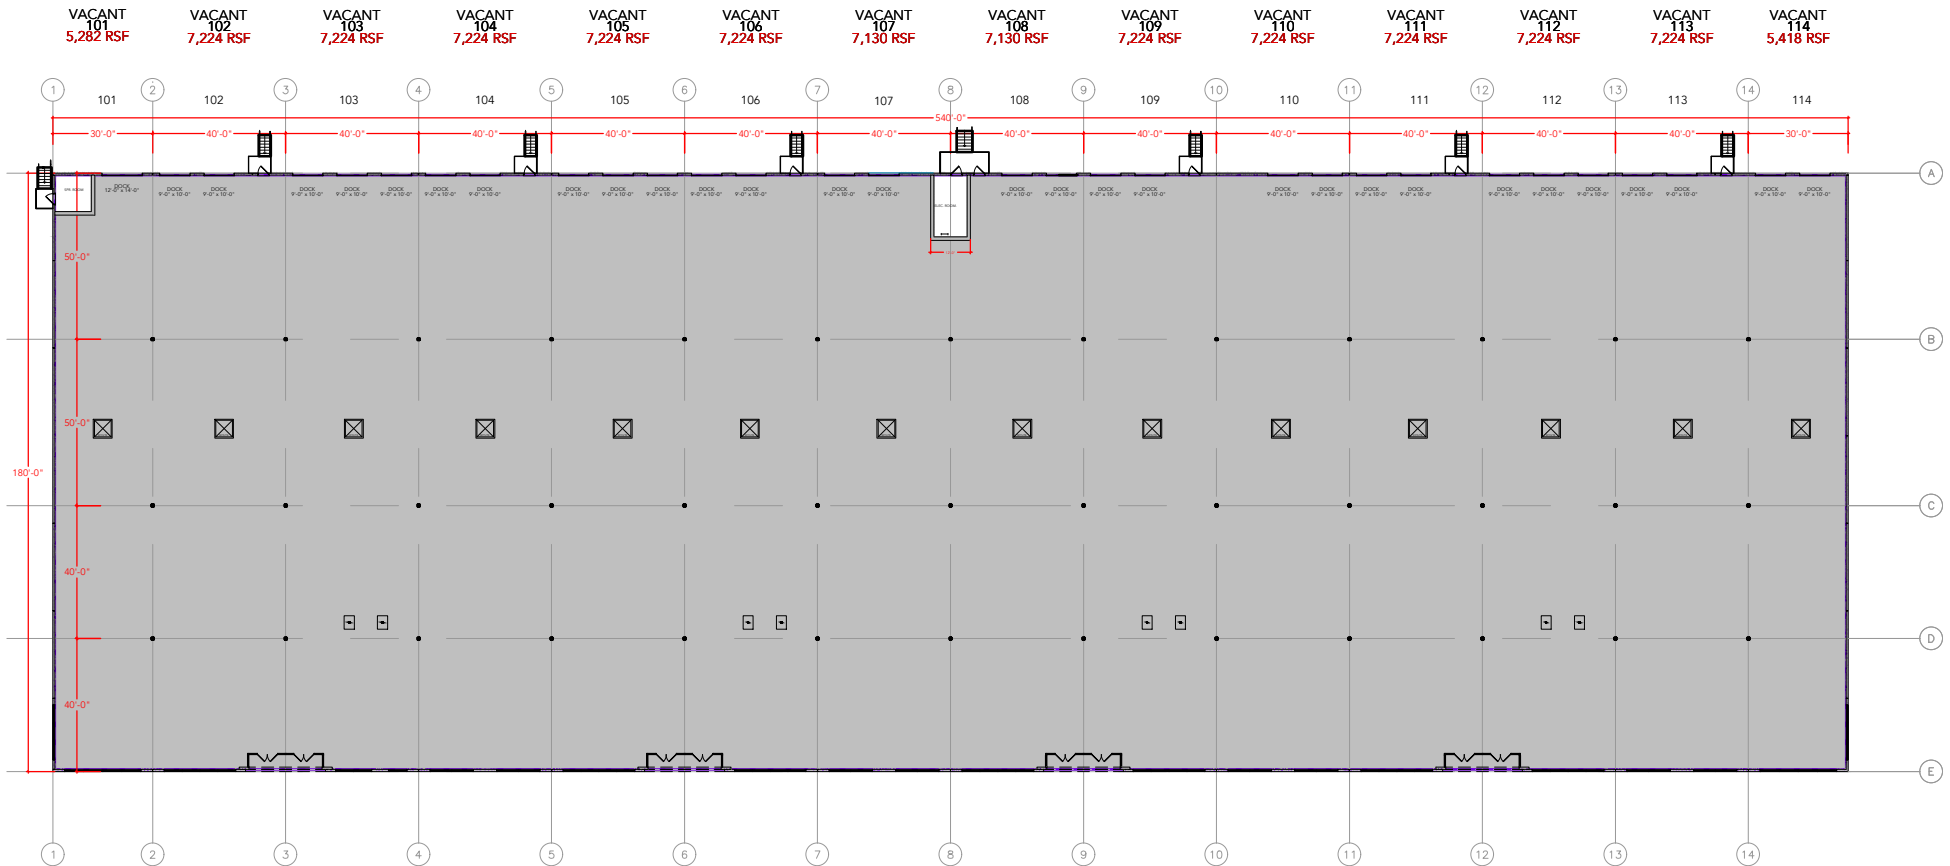

## Floor Plan