


Key Plan

**TOTAL SF AVAILABLE - 1,160 SF**

**OFFICE - 0,000 SF**

**WAREHOUSE - 0,000 SF**

[Click to access 3D model](#)

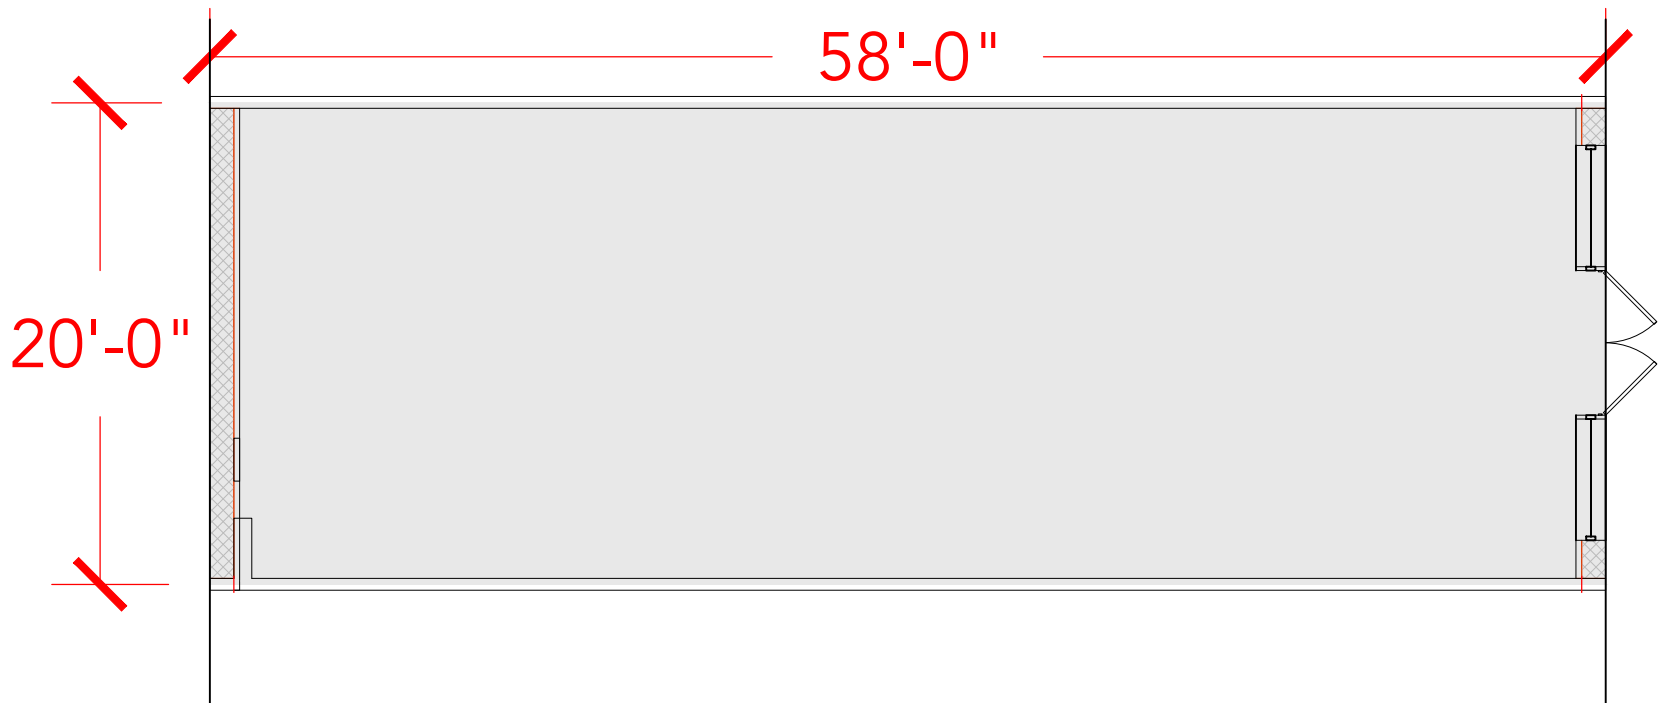

Floor Plan