


TOTAL SF AVAILABLE - 1,568 SF


OFFICE - 1,568 SF

WAREHOUSE - 0,000 SF

[Click to access 3D model](#)

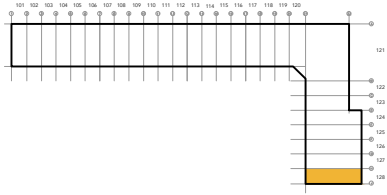

Key Plan

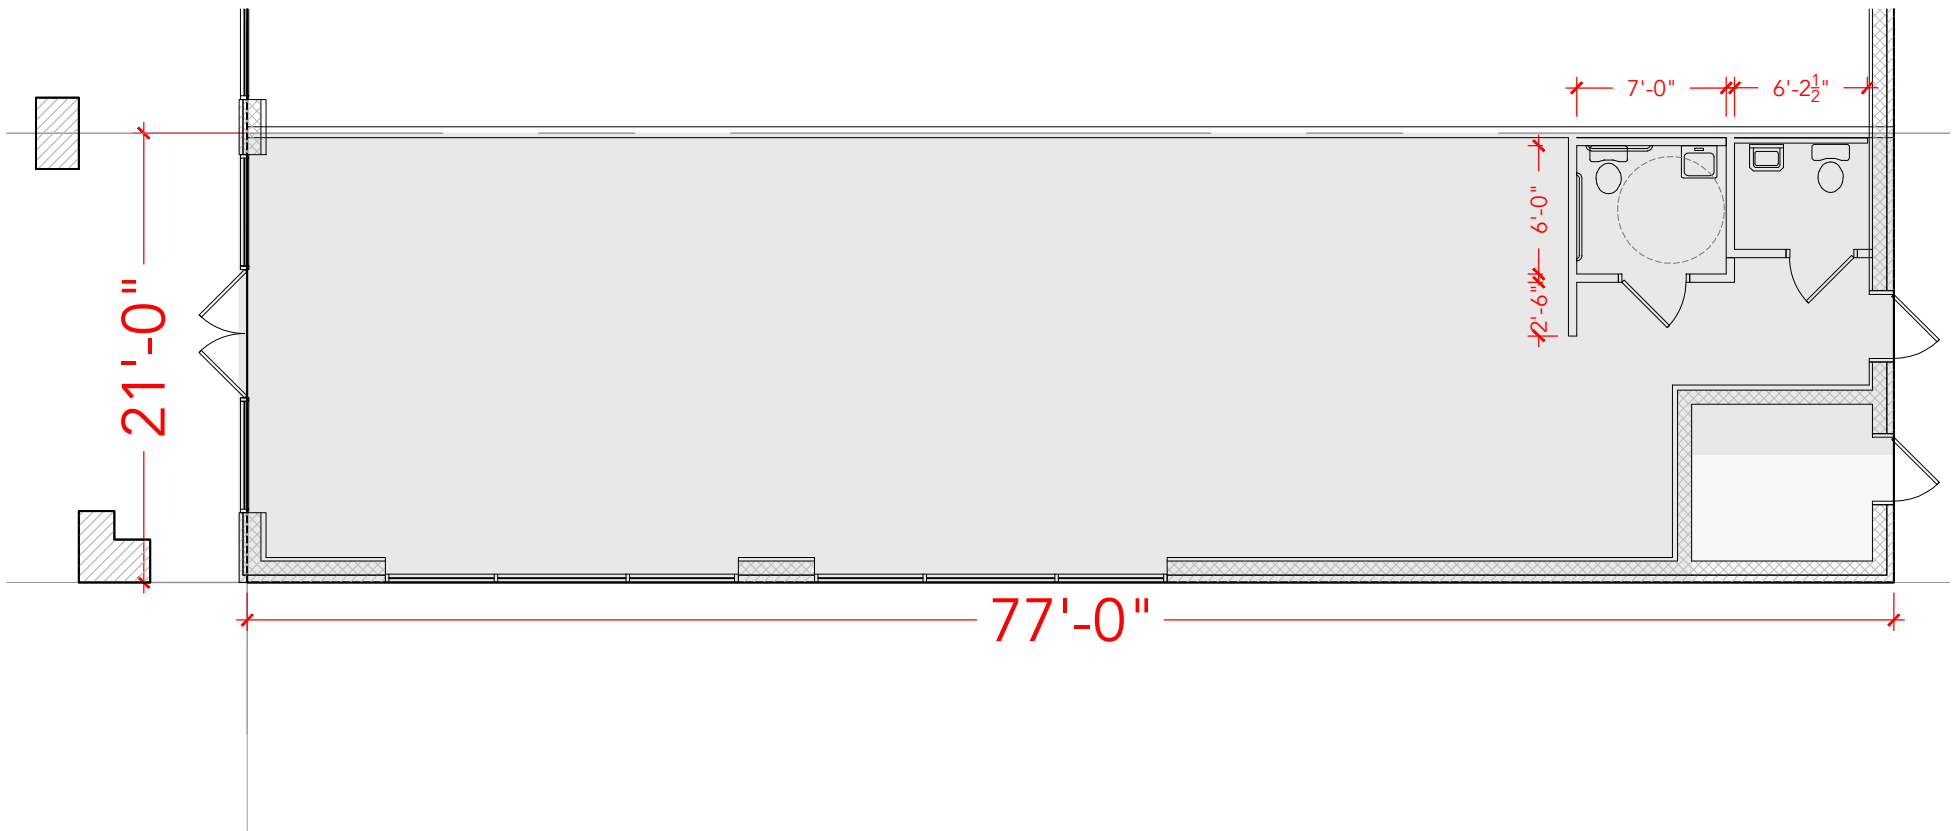

Floor Plan