


TOTAL SF AVAILABLE - 61,700 SF


OFFICE - 0,000 SF

WAREHOUSE - 61,700 SF

[Click to access 3D model](#)

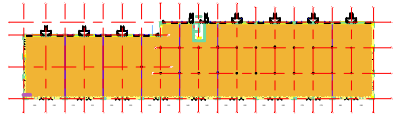

Key Plan

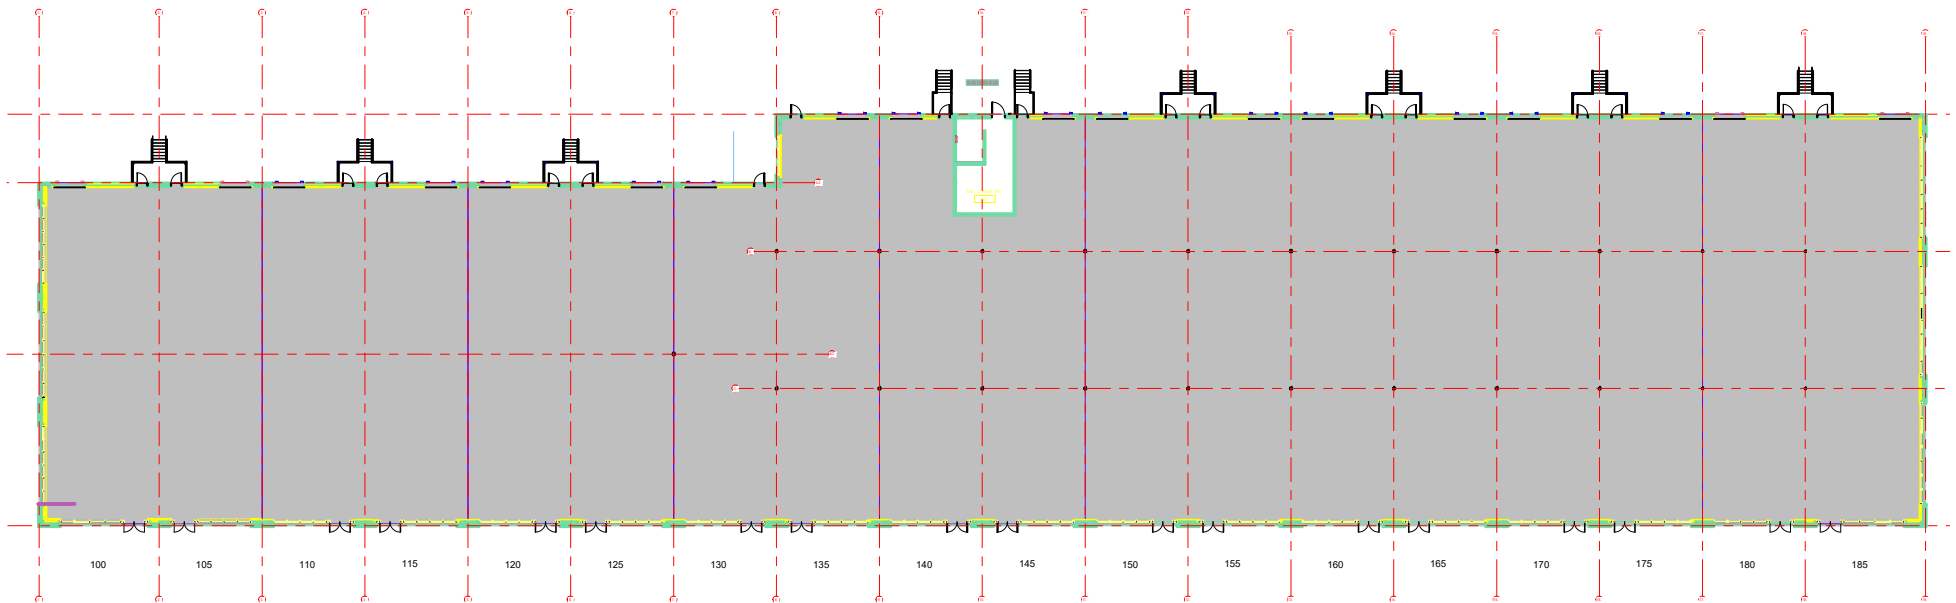

## Floor Plan