



TOTAL SF AVAILABLE - 22,401 RSF
INCLUDES % OF MECH. RM

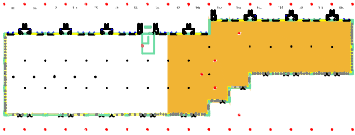

Key Plan

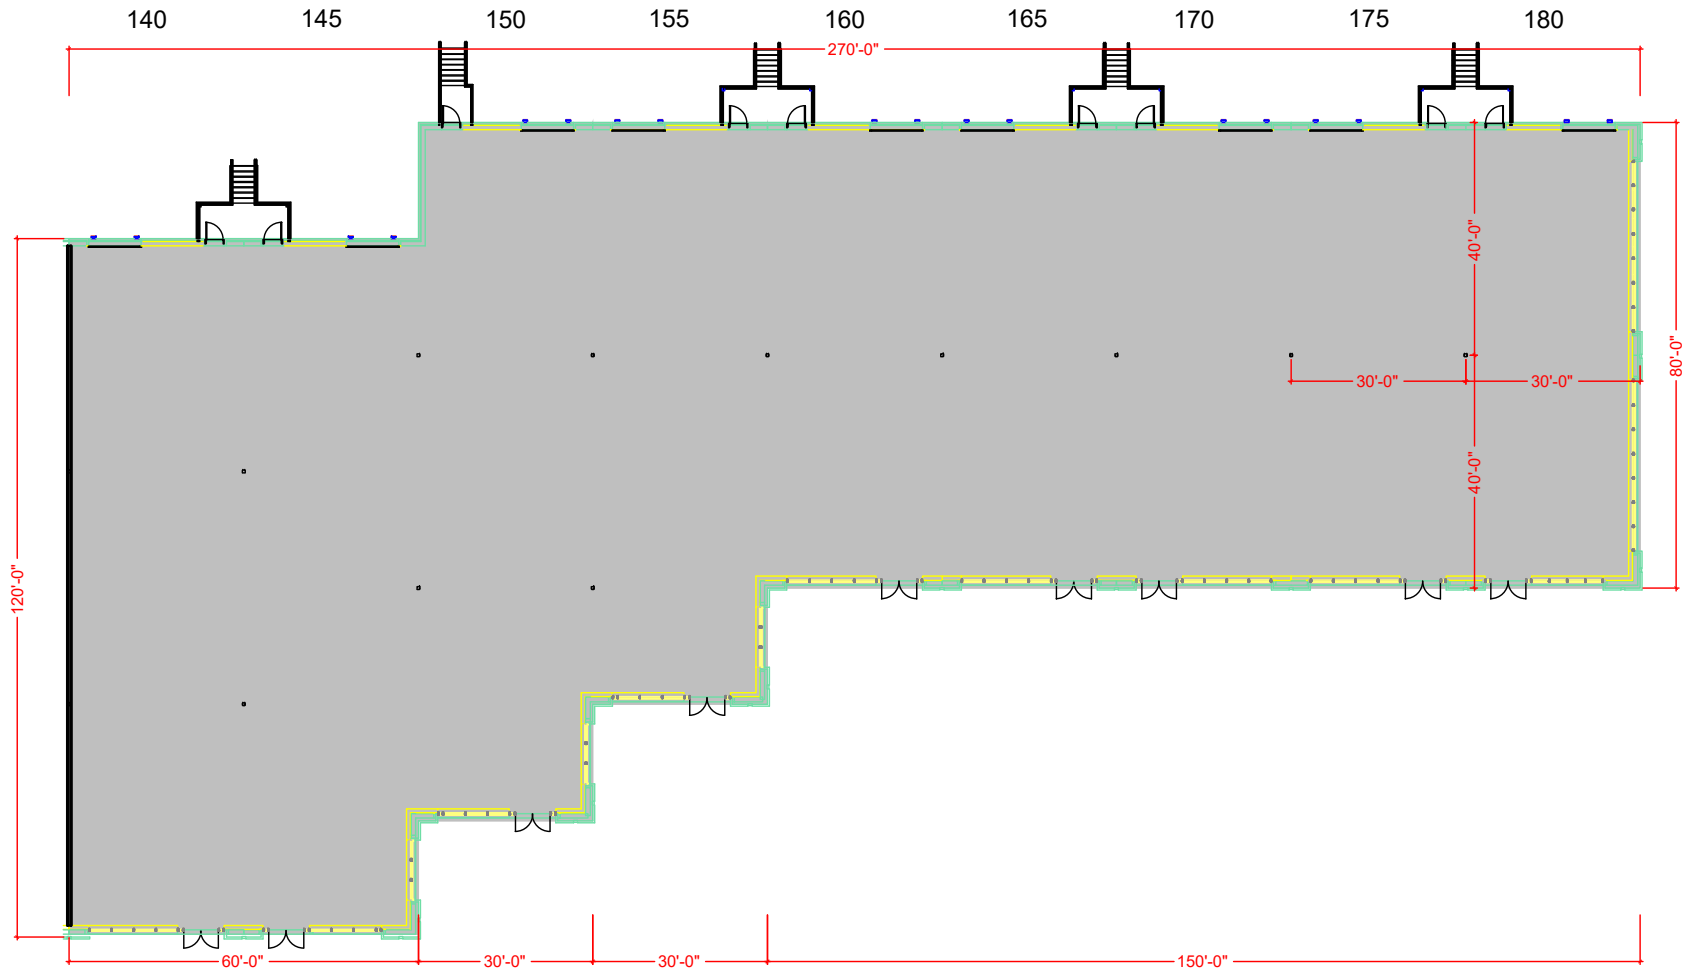

Floor Plan