



TOTAL SF AVAILABLE - 3,632 RSF

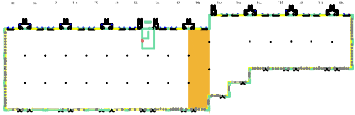

Key Plan

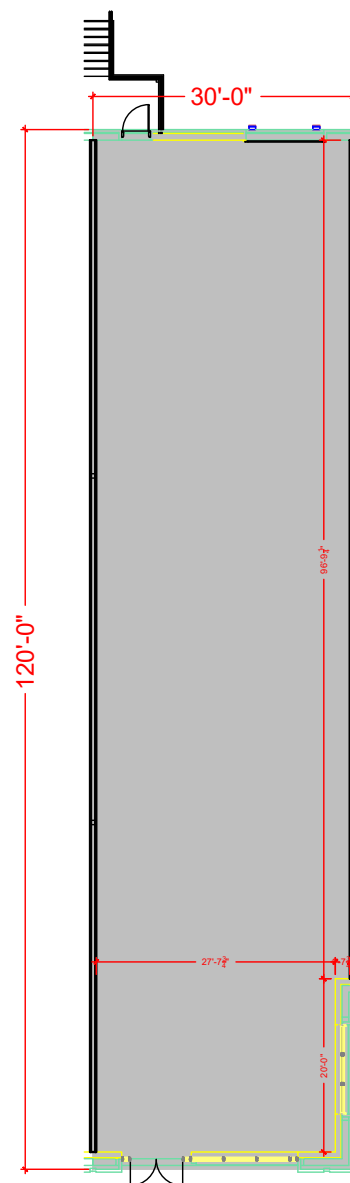

Floor Plan