

Key Plan


TOTAL SF AVAILABLE -4,937 RSF

OFFICE - 2,052 RSF

WAREHOUSE - 2,885 RSF

* INCLUDES % OF METER ROOM

[Click to access CADD file](#)

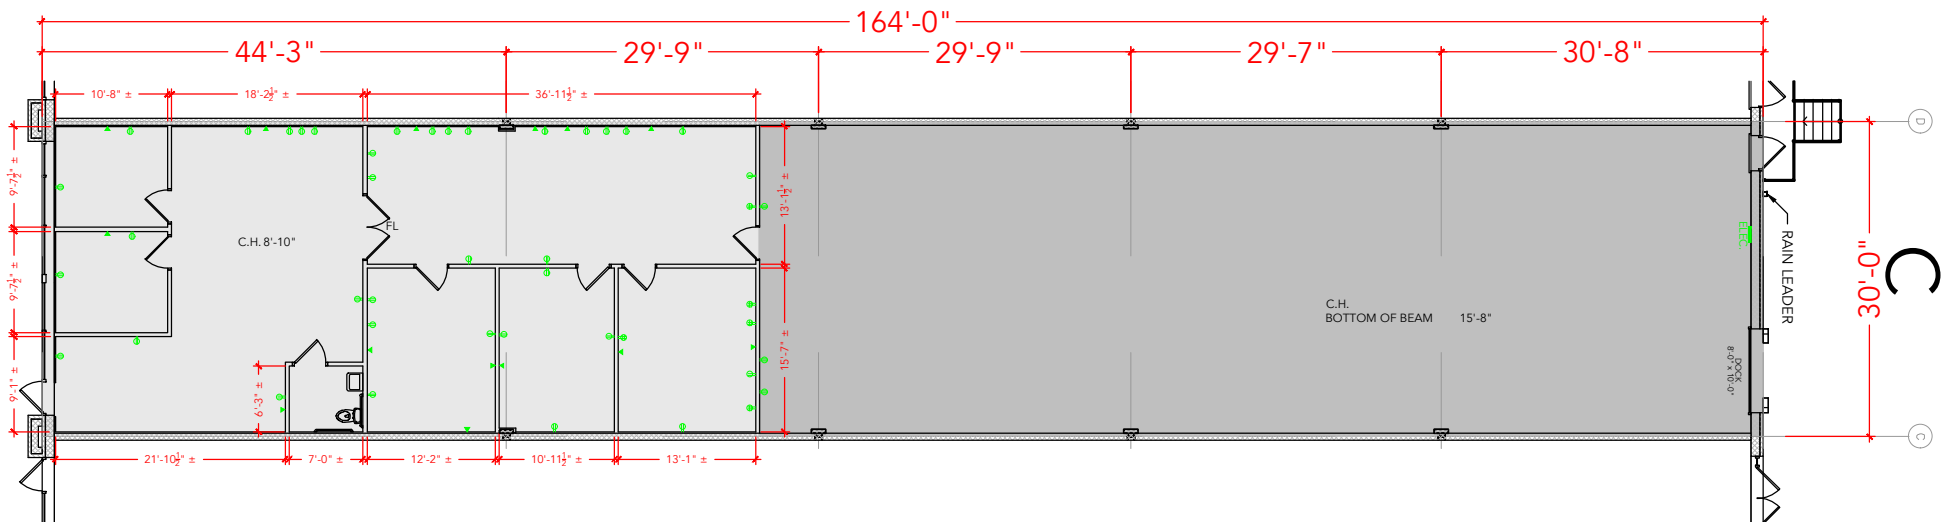

Floor Plan