

Key Plan


TOTAL SF AVAILABLE -24,534 RSF

OFFICE - 3,027 RSF

WAREHOUSE - 21,507 RSF

* INCLUDES % OF METER ROOM

[Click to access CADD file](#)

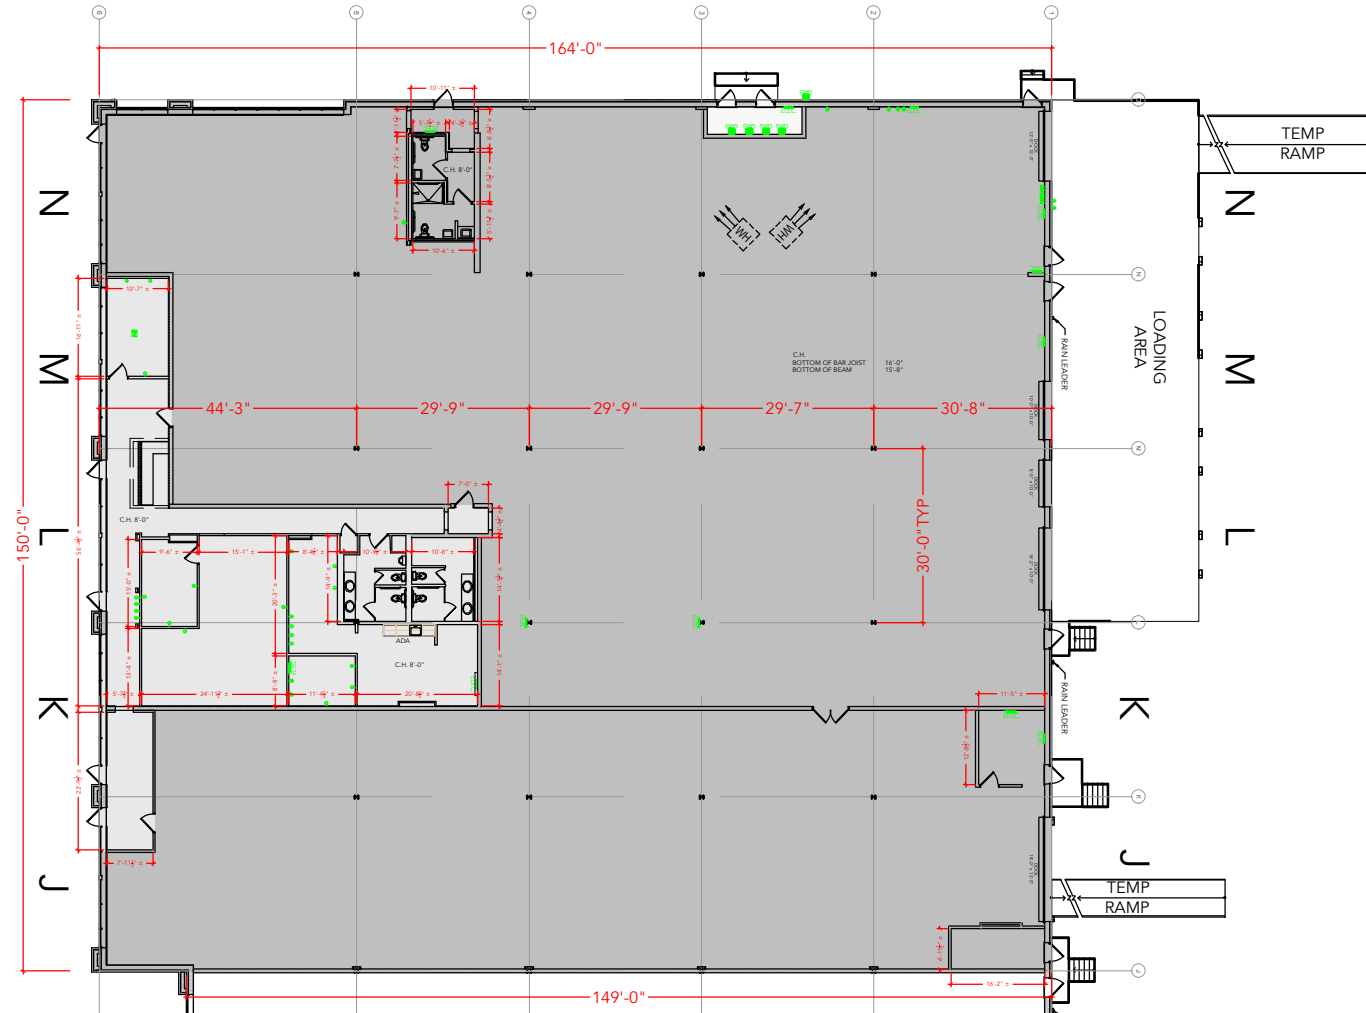

Floor Plan