



TOTAL SF AVAILABLE - 8,548 RSF (16%)

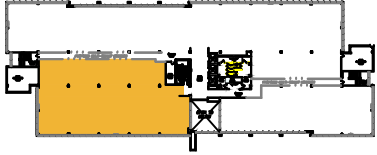

[Click to access 3D model](#)

## Key Plan

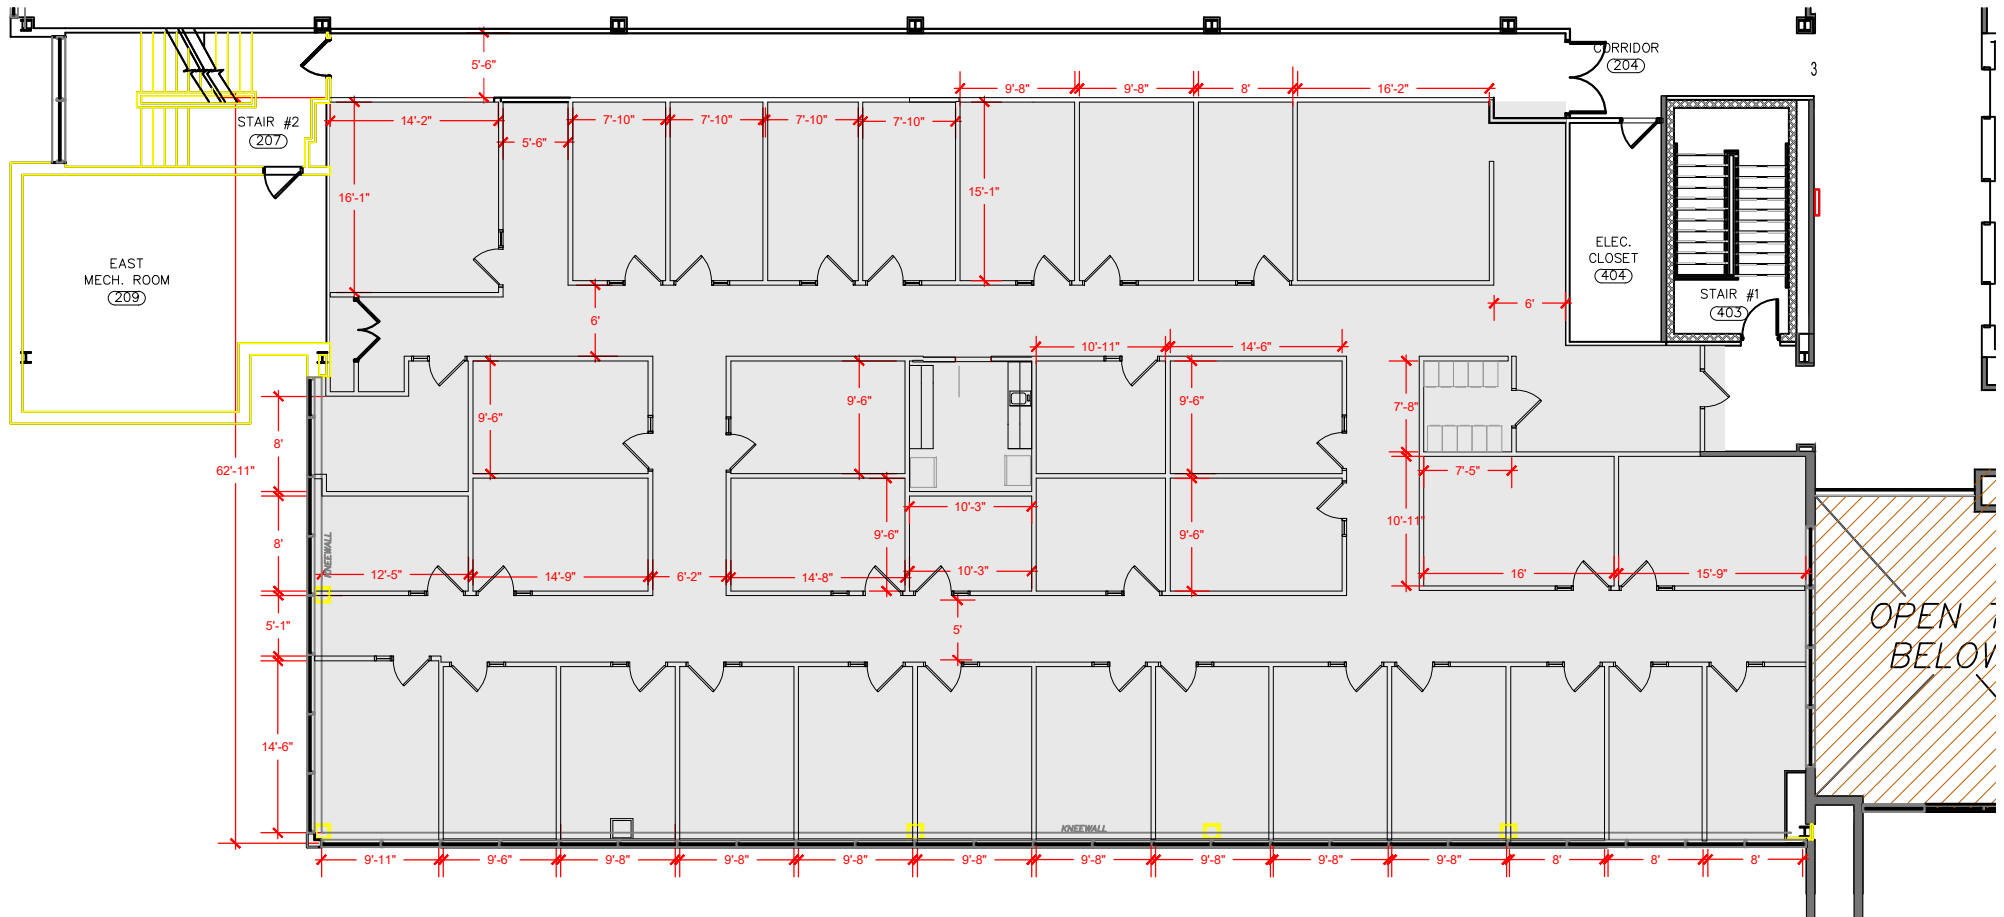

## Floor Plan