



TOTAL SF AVAILABLE - 14,799 RSF(12%)

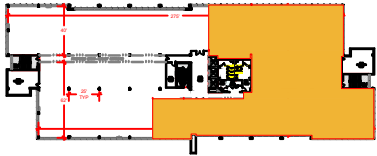

[Click to access 3D model](#)

Key Plan

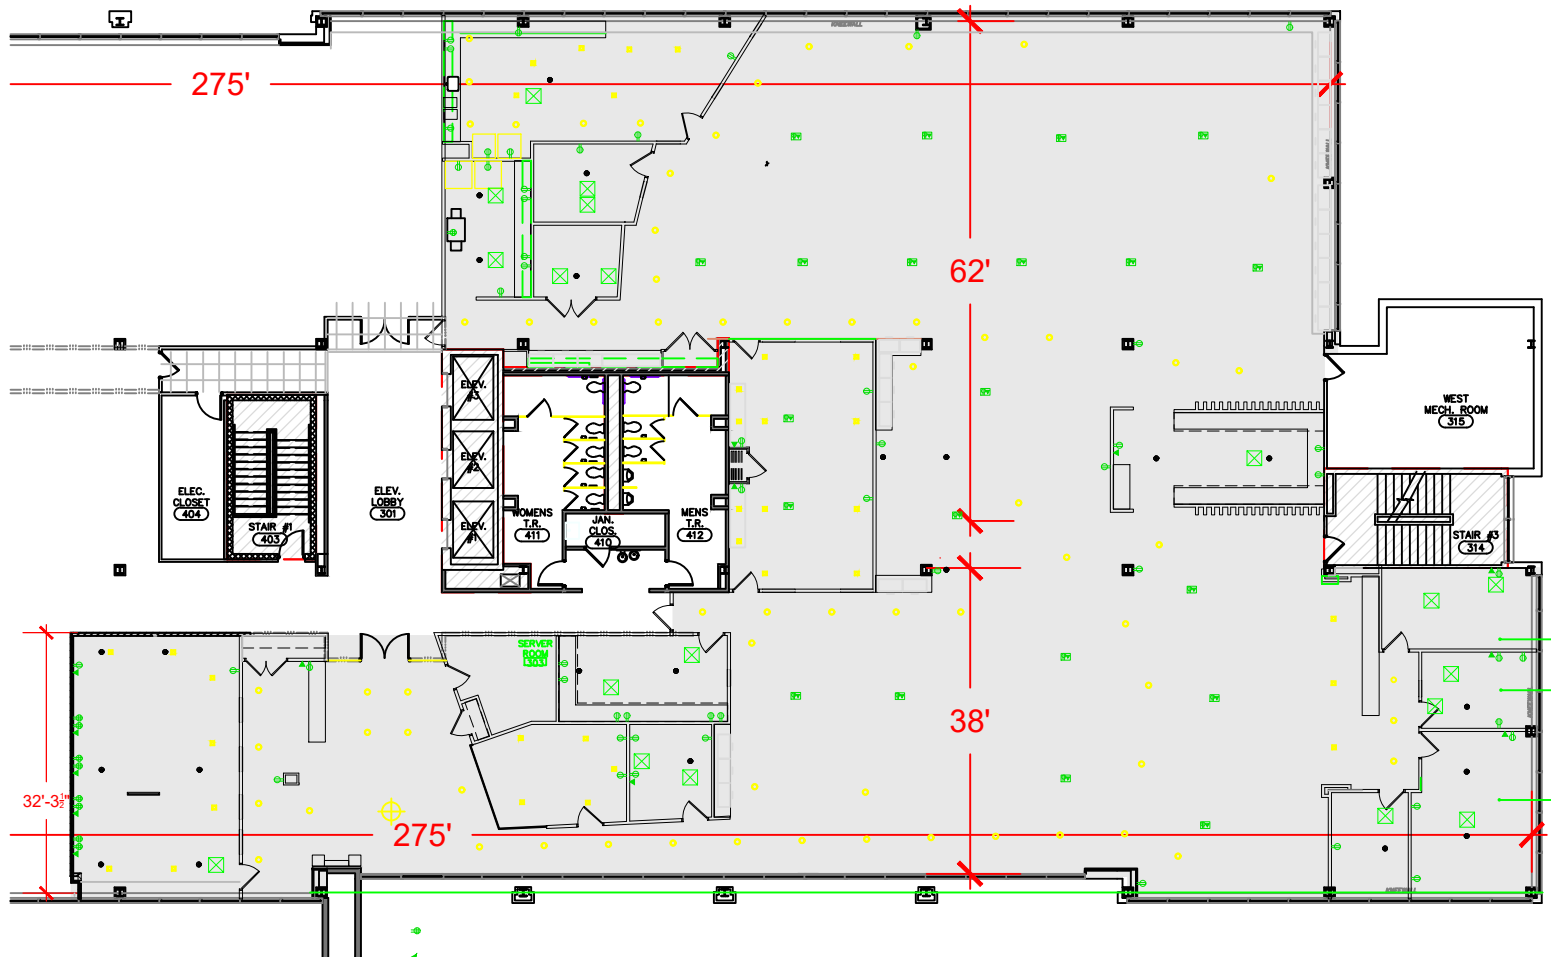

Floor Plan