



TOTAL SF AVAILABLE - 3,406 RSF (12%)

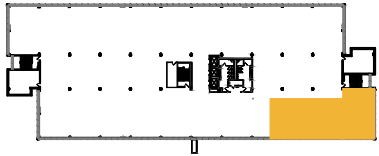

Key Plan

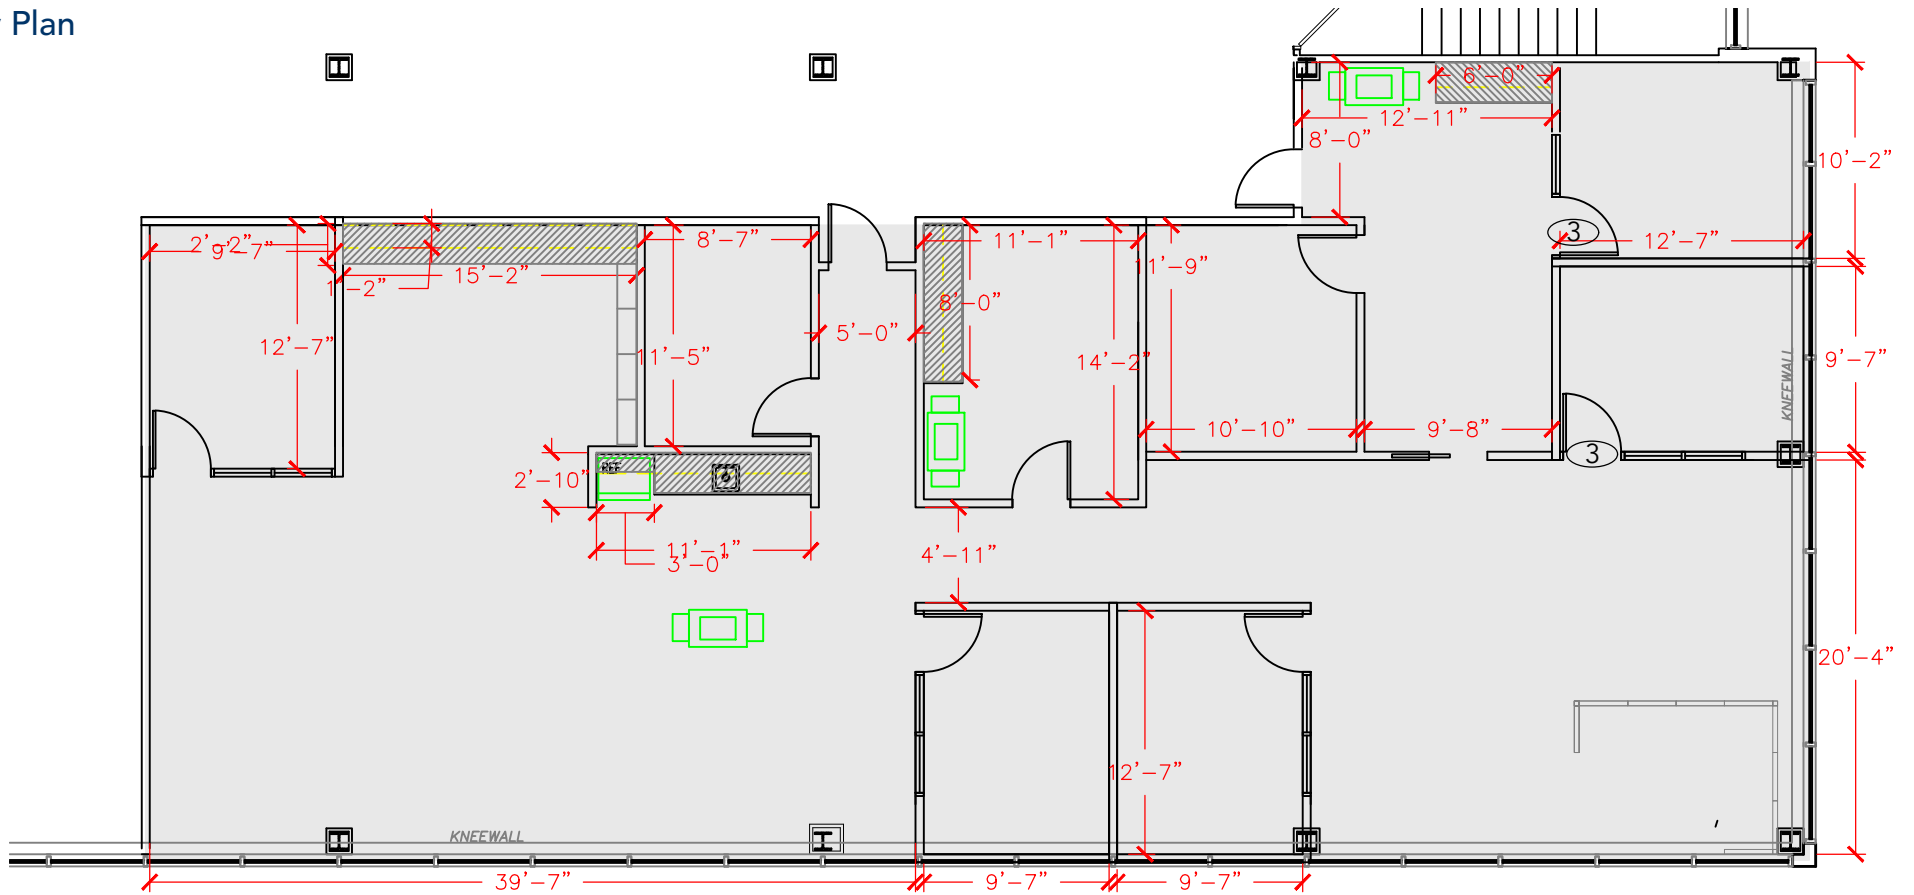

Floor Plan