



TOTAL SF AVAILABLE - 1,938 RSF (16%)

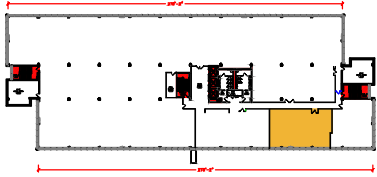

[Click to access 3D model](#)

Key Plan

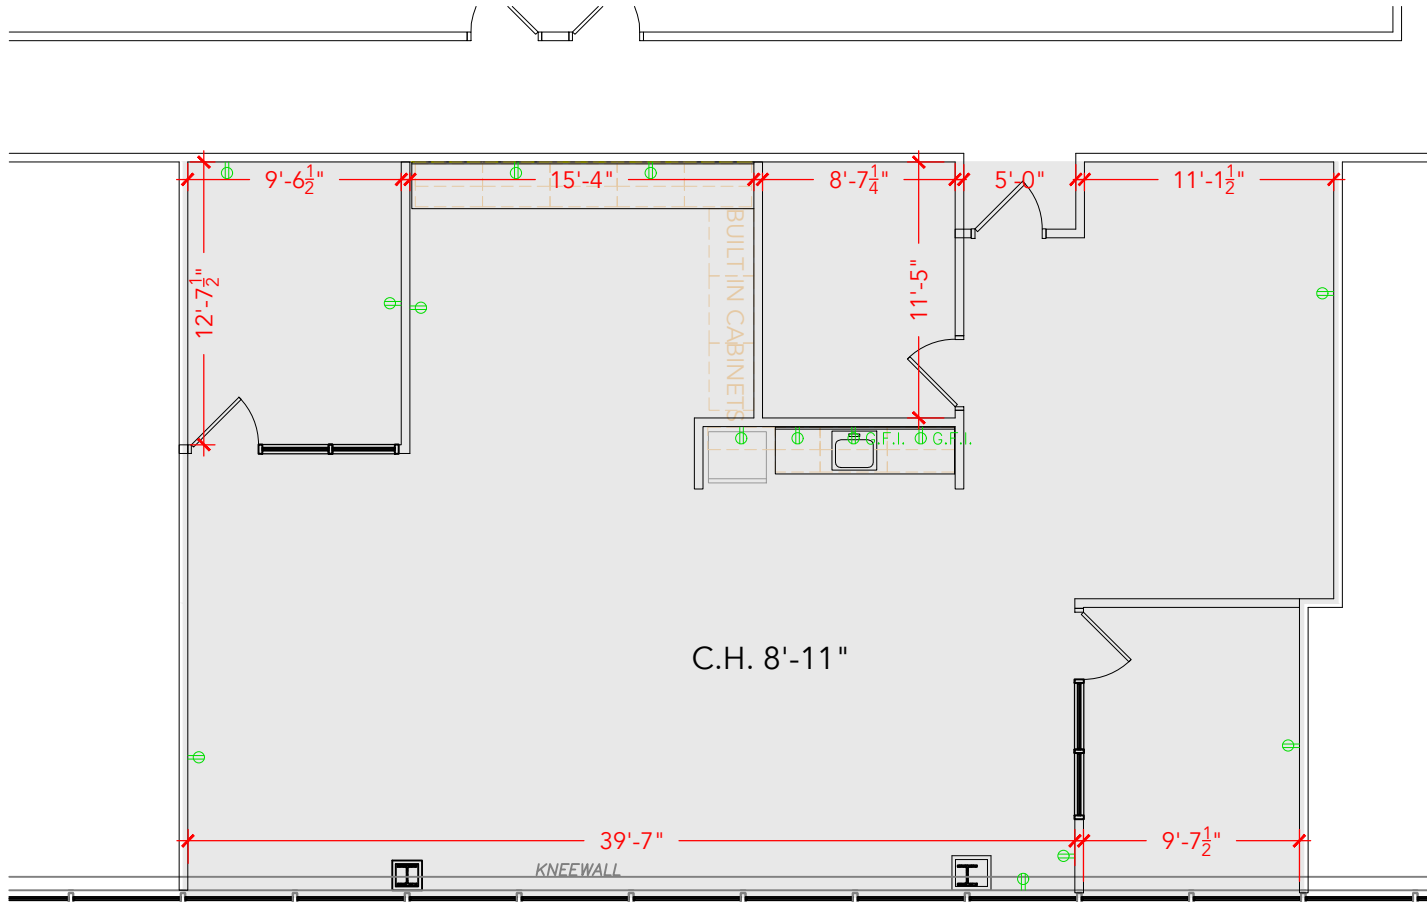

## Floor Plan