



TOTAL SF AVAILABLE - 951 RSF(16%)

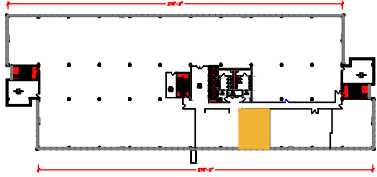

Key Plan

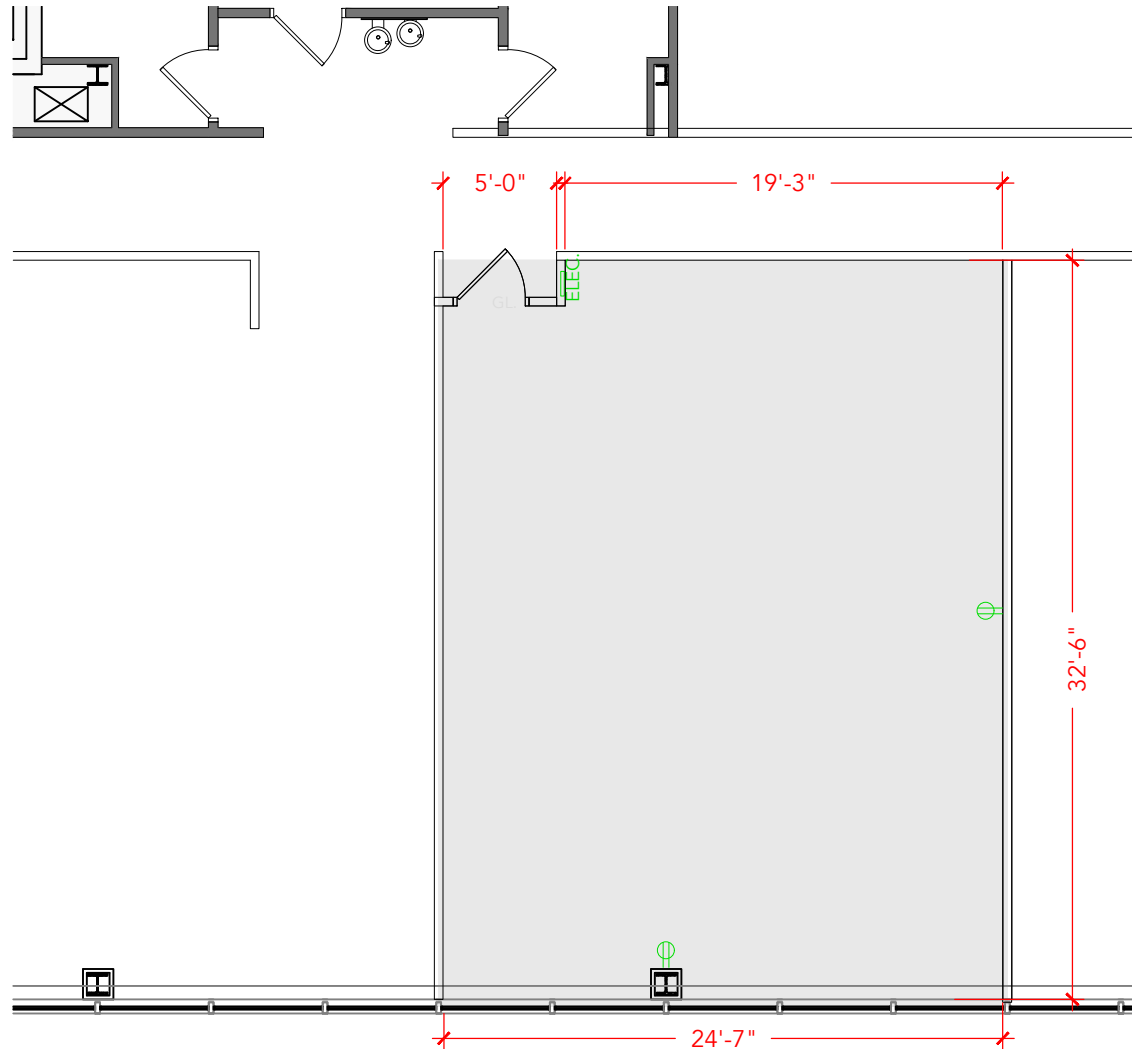

Floor Plan