



TOTAL SF AVAILABLE - 5,400 SF

OFFICE - 0,000 SF  
WAREHOUSE SF - 5,400 SF

[Click to access 3D model](#)

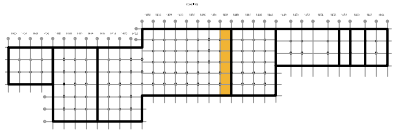

Key Plan

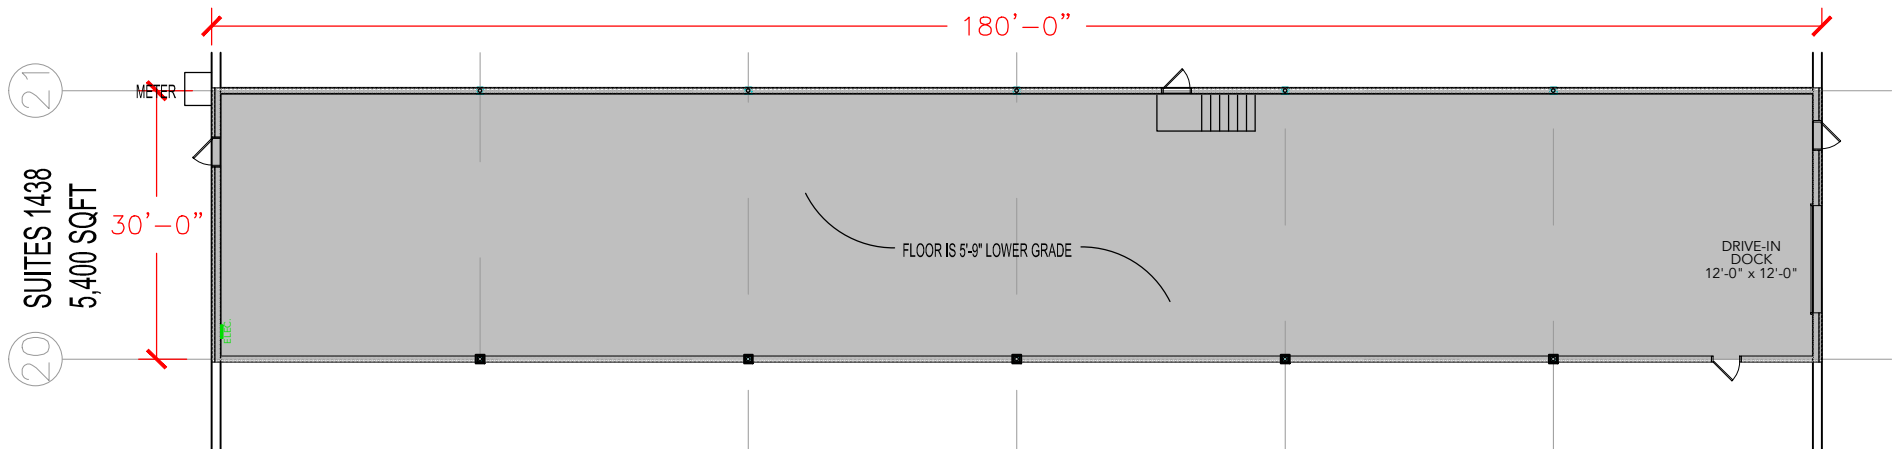

Floor Plan