

**TOTAL SF AVAILABLE -19,027 RSF**


**OFFICE - 3,909 RSF**

**WAREHOUSE - 15,119 RSF**


\* INCLUDES % OF METER ROOM

[Click to access CADD file](#)

\*1,618 SQFT MEZZ NOT INCLUDED IN TOTAL SQFT

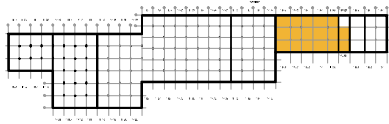

Key Plan

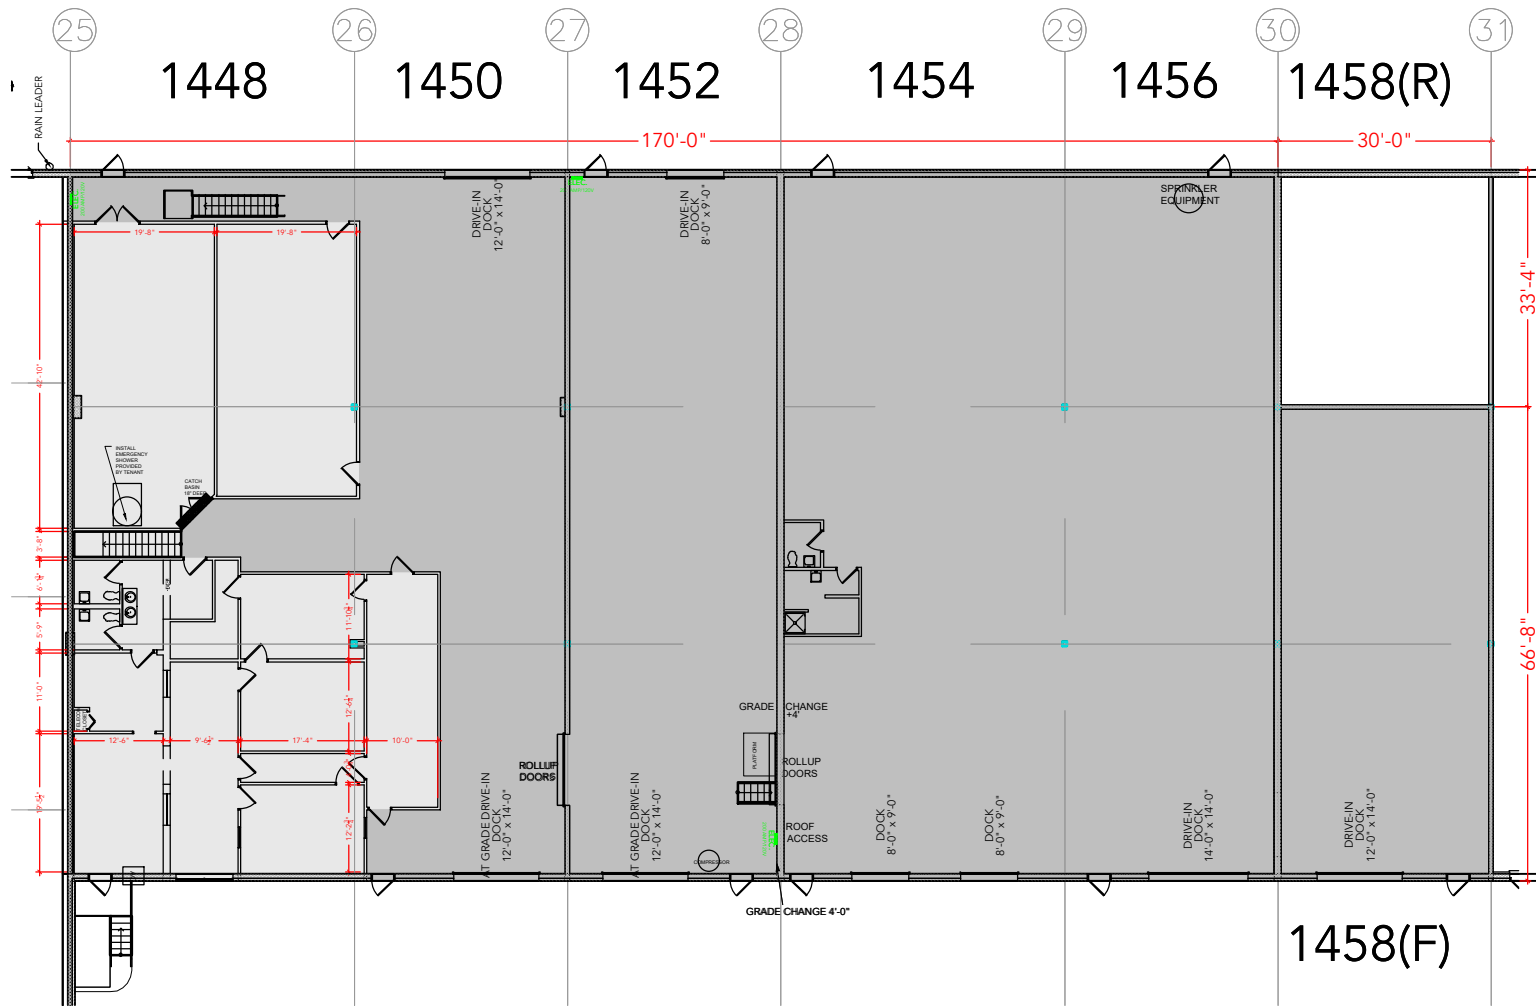

Floor Plan