


TOTAL SF AVAILABLE - 4,000 SF


OFFICE - 756 SF

WAREHOUSE - 3,244 SF

[Click to access 3D model](#)

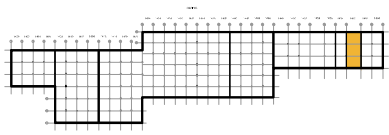

Key Plan

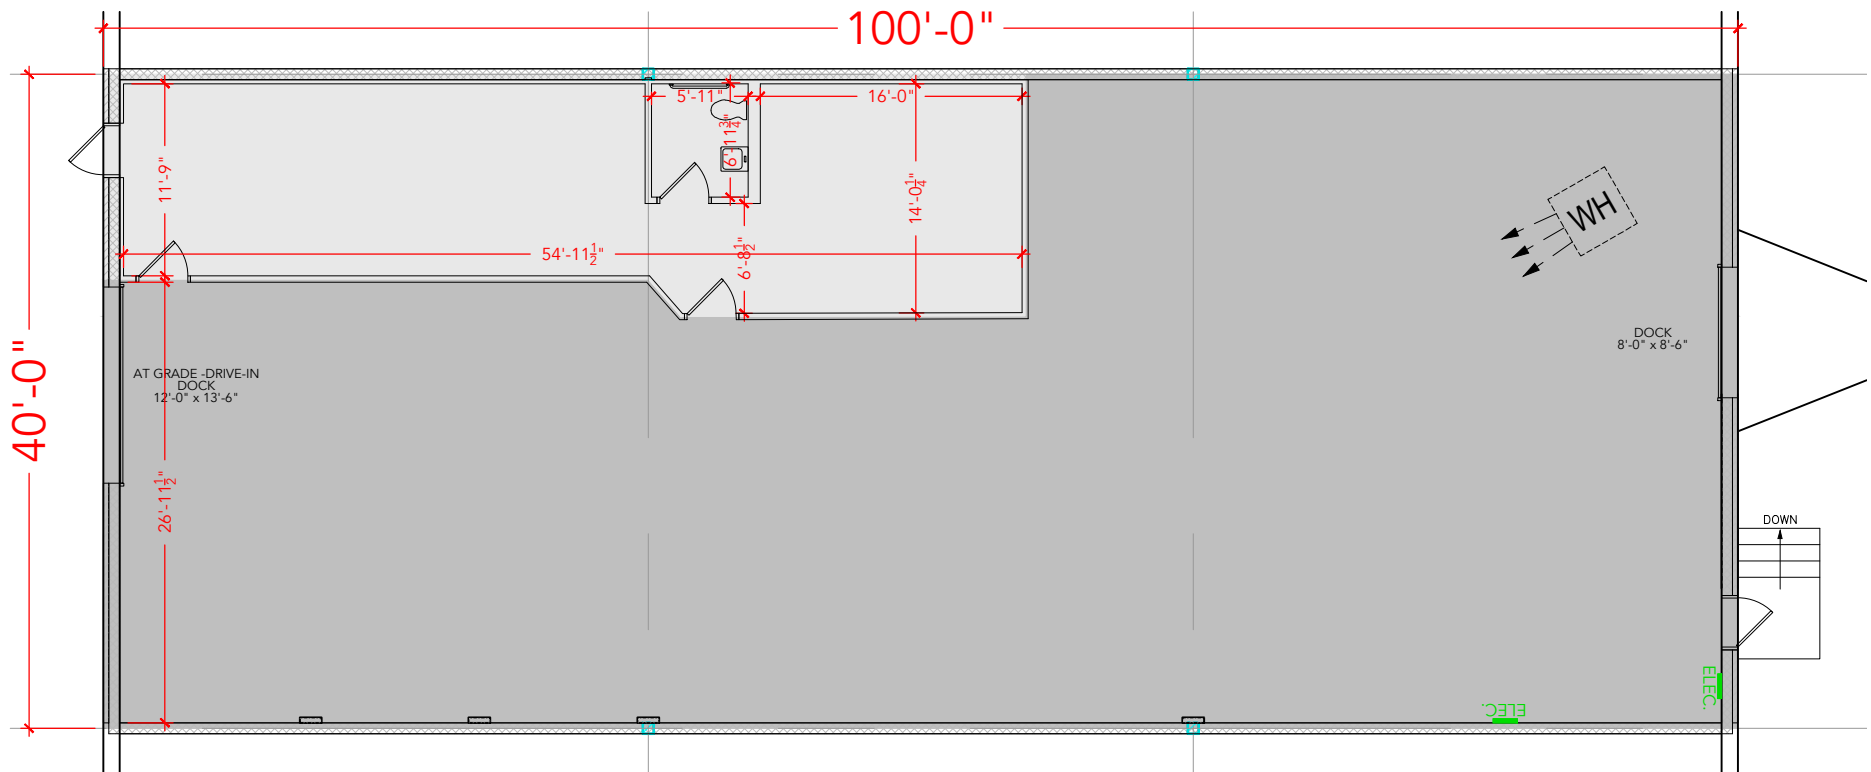

Floor Plan