


TOTAL SF AVAILABLE - 4,000 SF


OFFICE - 744 SF

WAREHOUSE - 3,226 SF

[Click to access 3D model](#)

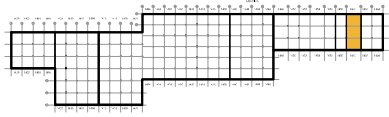

Key Plan

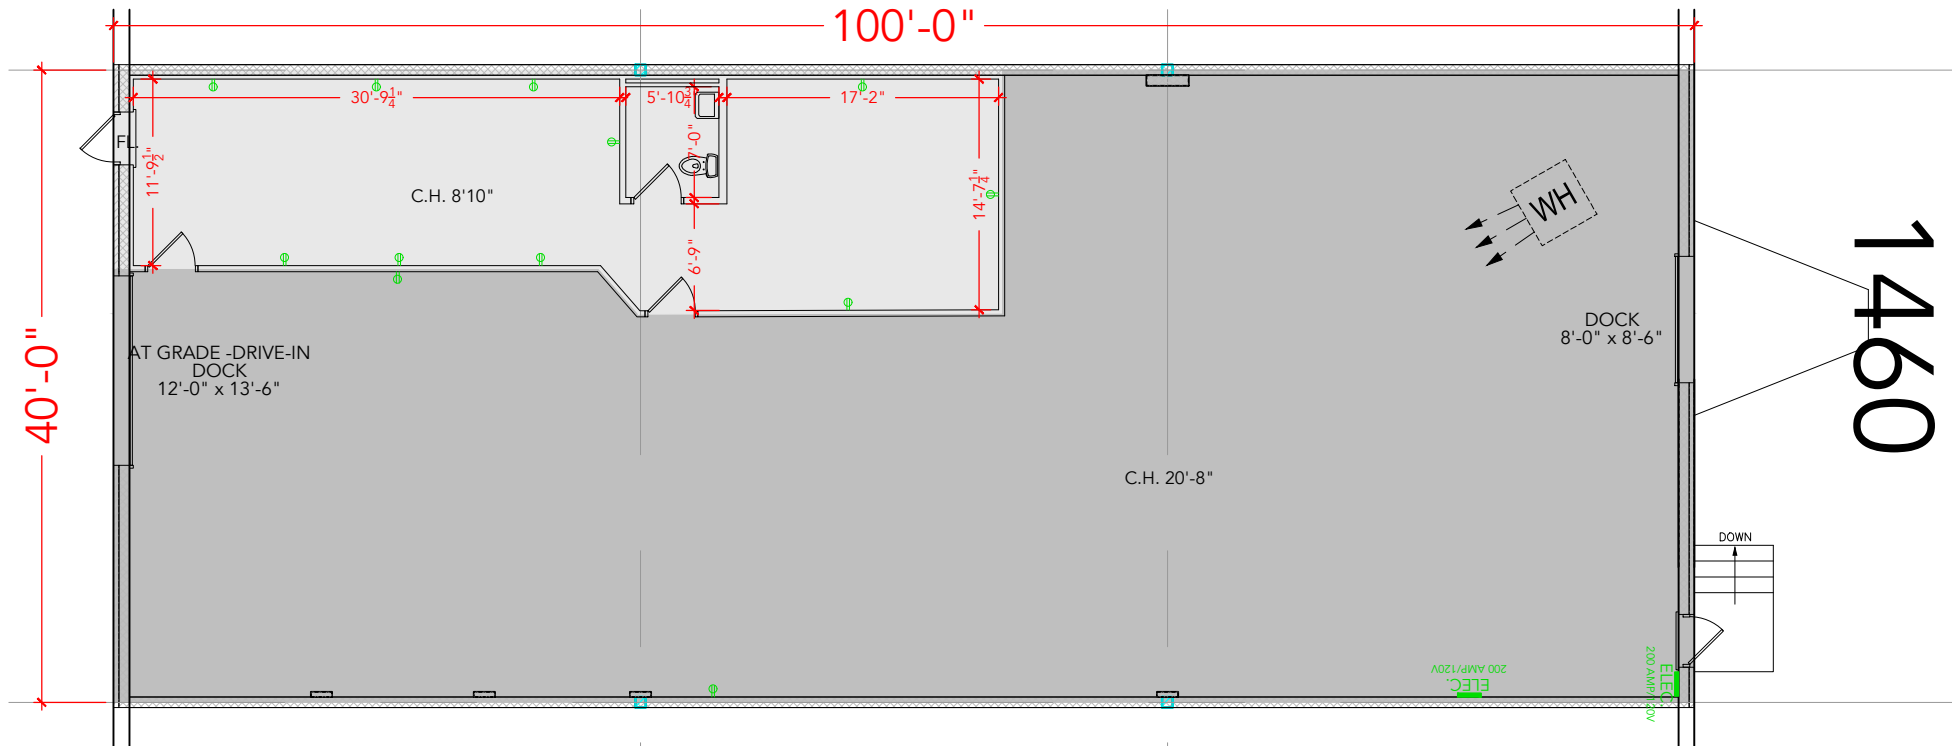

1460

Floor Plan