


TOTAL SF AVAILABLE - 14,400 SF


OFFICE - 4,704 SF

WAREHOUSE - 9,696 SF

[Click to access 3D model](#)

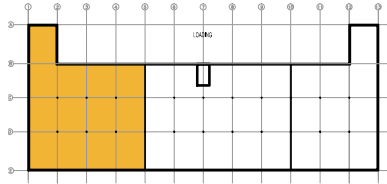

Key Plan

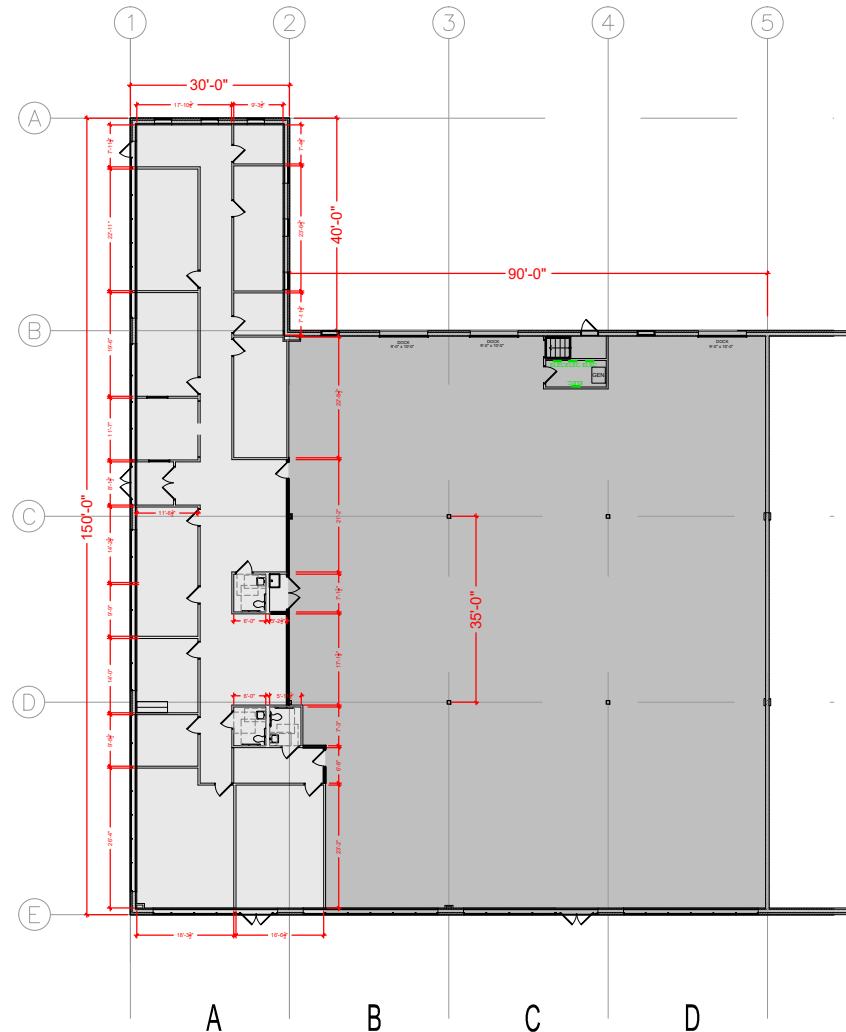

Floor Plan