


TOTAL SF AVAILABLE - 13,018 RSF


OFFICE - 3,792 RSF

WAREHOUSE SF - 9,226 RSF

[Click to access 3D model](#)

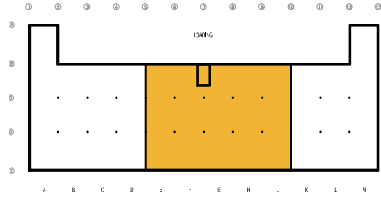

Key Plan

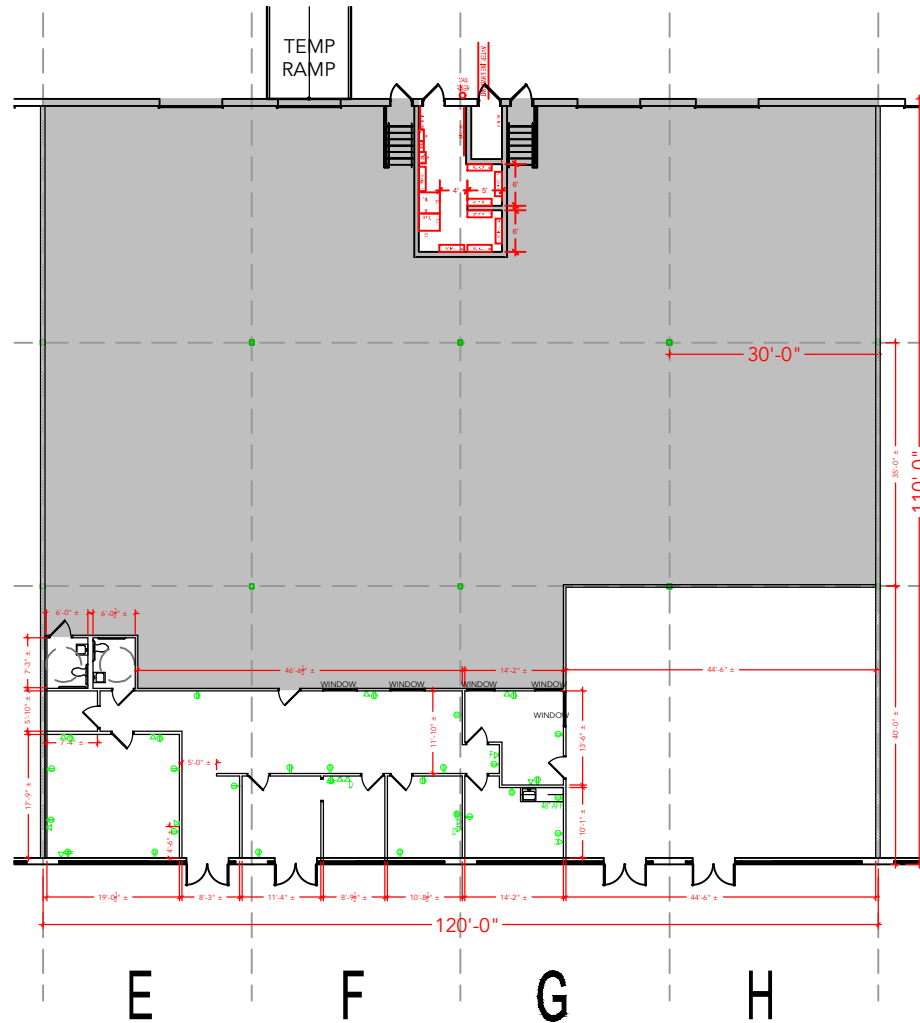

Floor Plan