


TOTAL SF AVAILABLE -13,016 RSF

OFFICE - 3,926 RSF


WAREHOUSE - 9,090 RSF

* INCLUDES % OF METER ROOM

[Click to access CADD file](#)

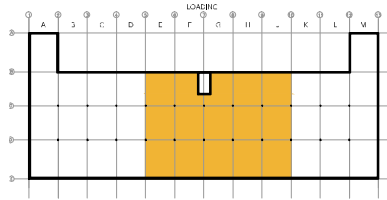

Key Plan

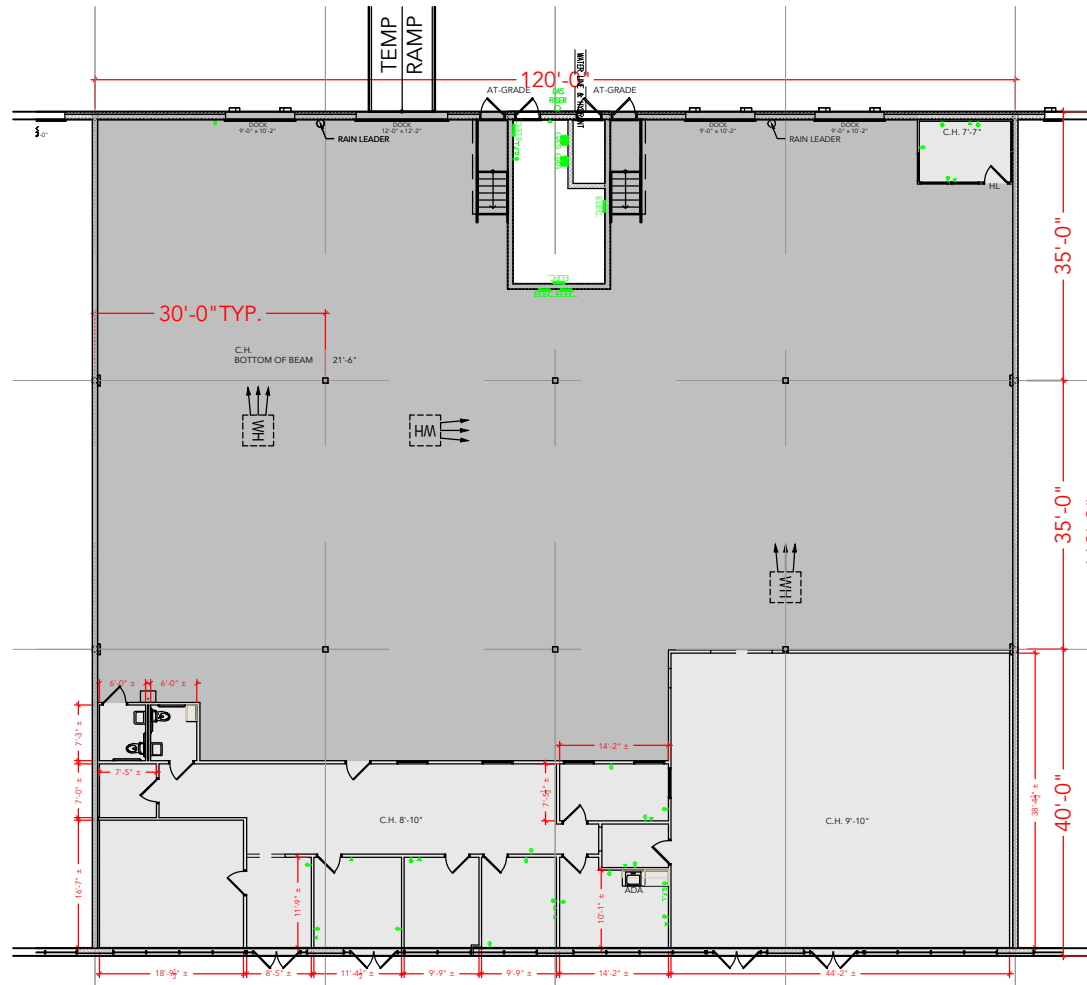

Floor Plan