


TOTAL SF AVAILABLE - 6,000 SF


OFFICE - 5,000 SF

WAREHOUSE - 1,000 SF

[Click to access 3D model](#)

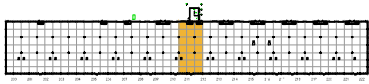

Key Plan

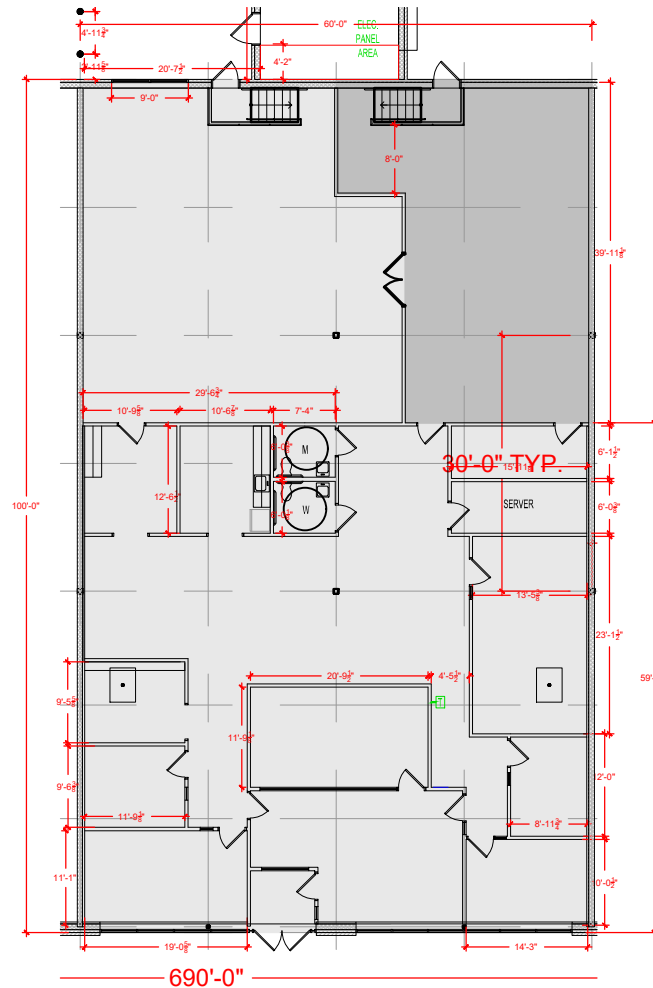

Floor Plan