


TOTAL SF AVAILABLE - 6,000 SF


OFFICE - 2,019 SF

WAREHOUSE SF - 3,981 SF

[Click to access 3D model](#)

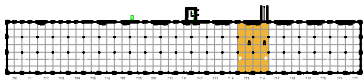

Key Plan

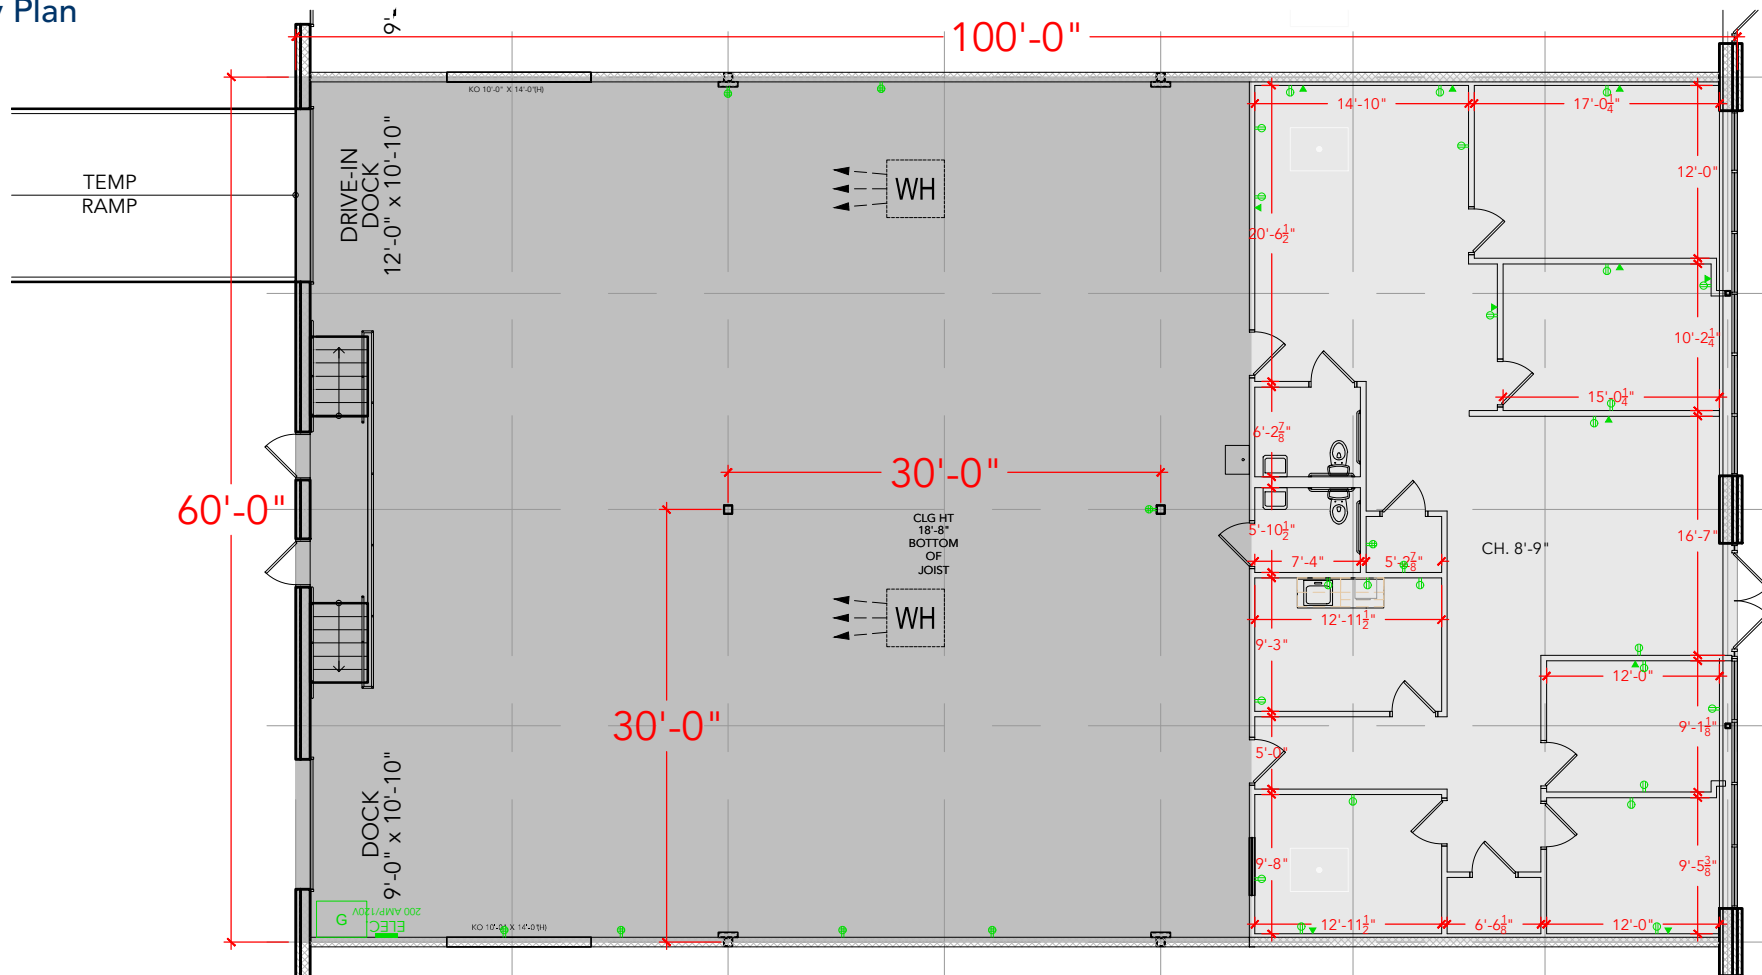

216
215

Floor Plan