


TOTAL SF AVAILABLE - 12,000 SF

OFFICE - 5,306 SF

WAREHOUSE SF - 6,694 SF

[Click to access 3D model](#)

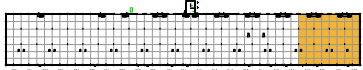

Key Plan



Floor Plan