


TOTAL SF AVAILABLE -33,300 SF


OFFICE - 0,000 SF

WAREHOUSE SF - 33,300 SF

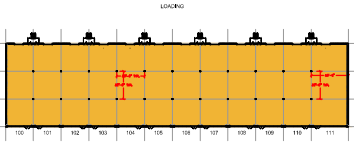

Key Plan

LOADING

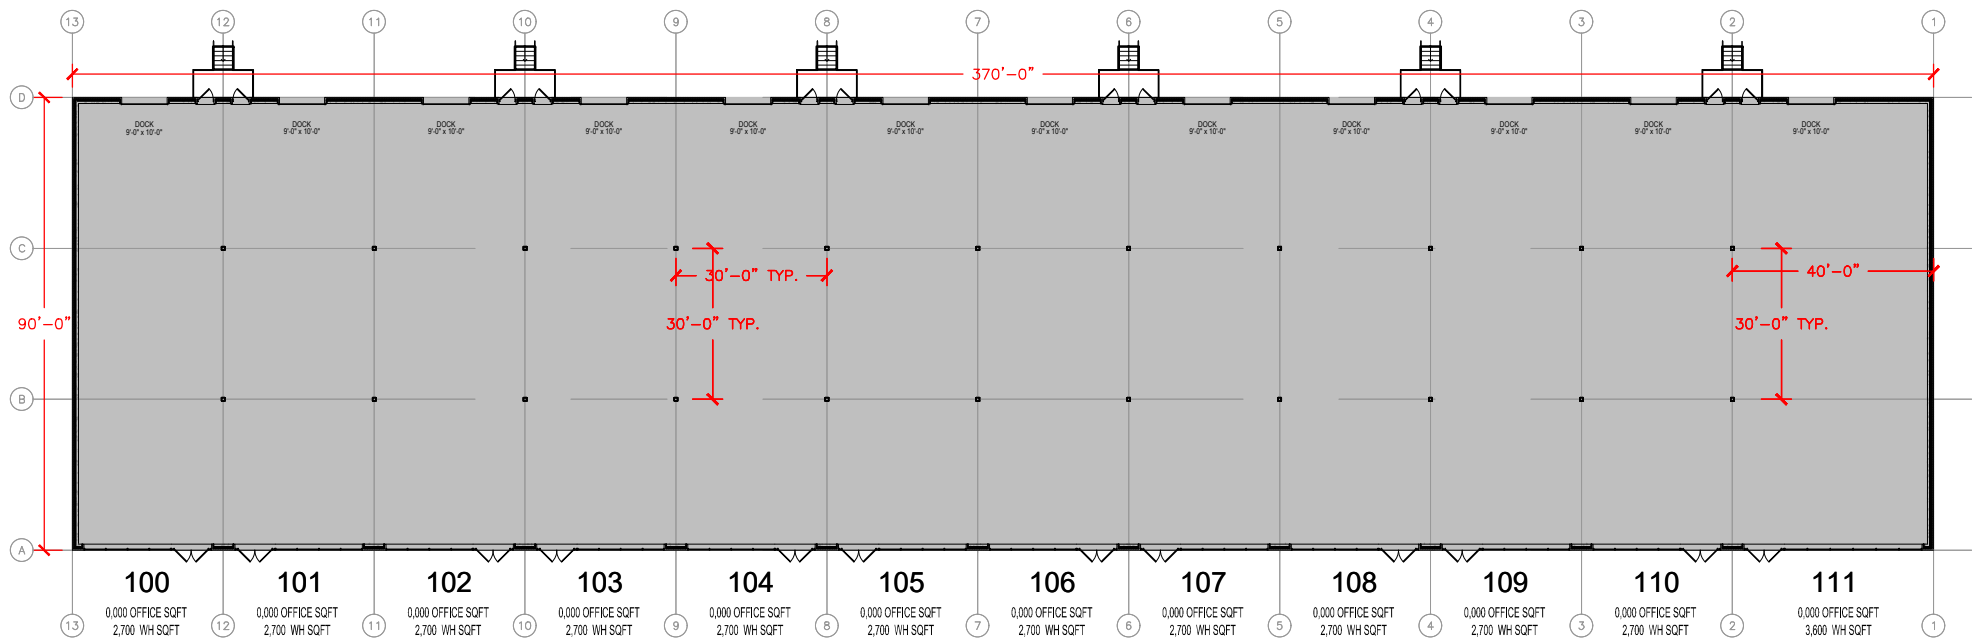

Floor Plan