


TOTAL SF AVAILABLE -4,000 SF


OFFICE - 1,500 SF

WAREHOUSE SF - 2,500 SF

[Click to access 3D model](#)

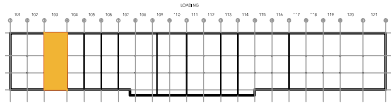

Key Plan

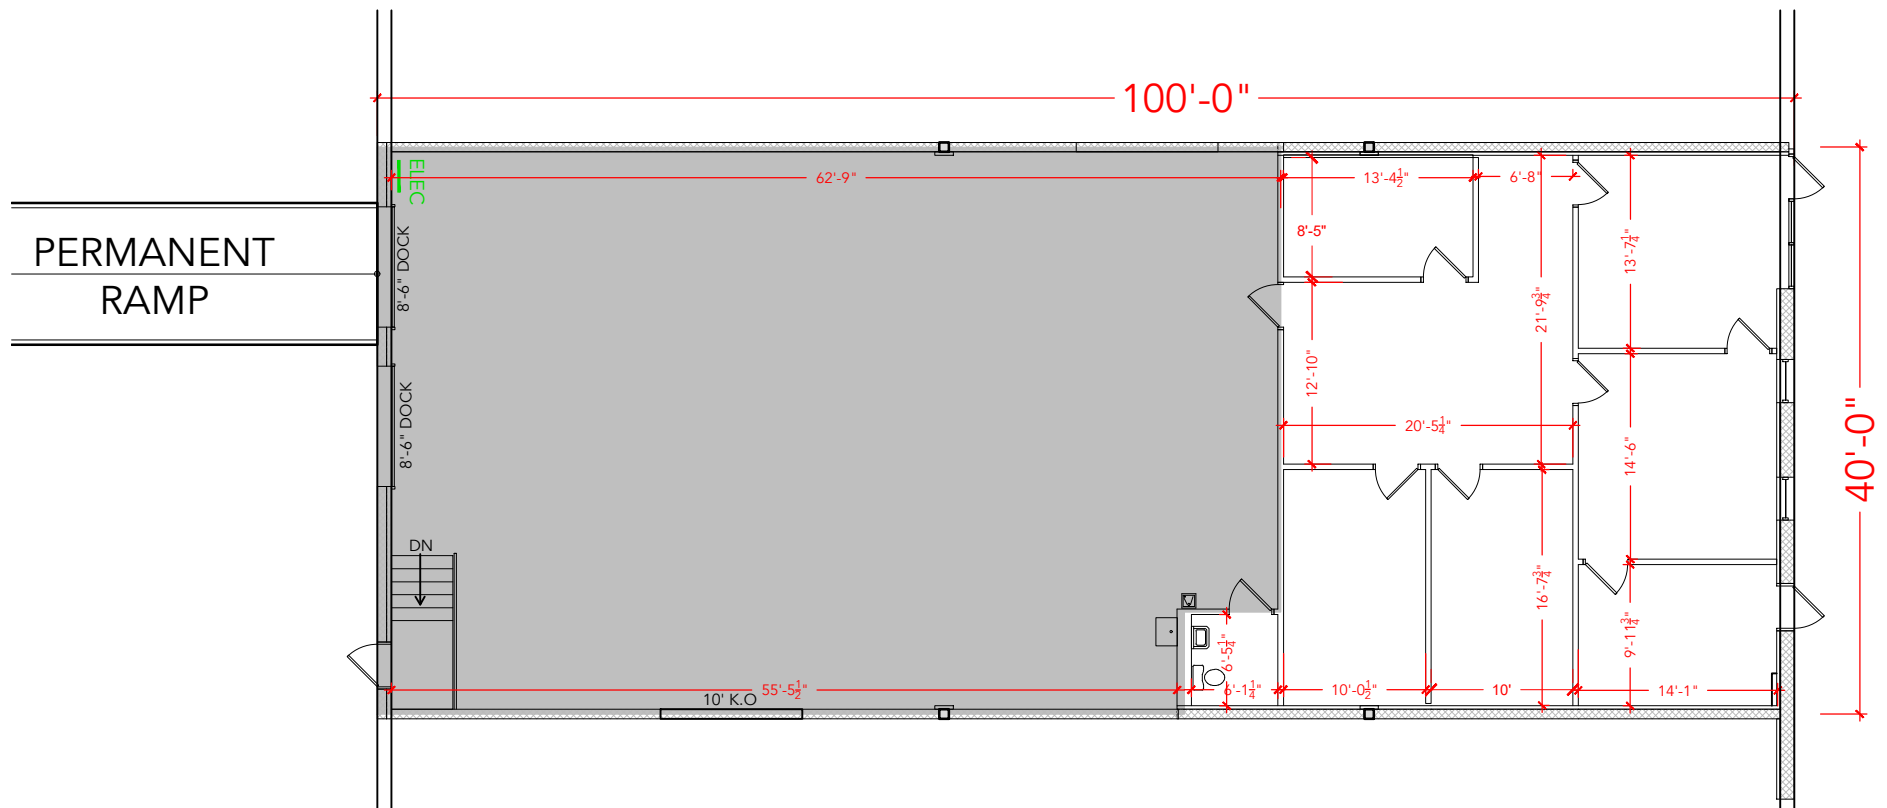

Floor Plan