


TOTAL SF AVAILABLE - 3,000 SF


OFFICE - 445 SF

WAREHOUSE - 2,555 SF

[Click to access 3D model](#)

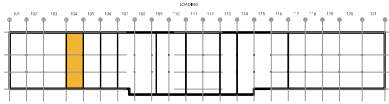

Key Plan

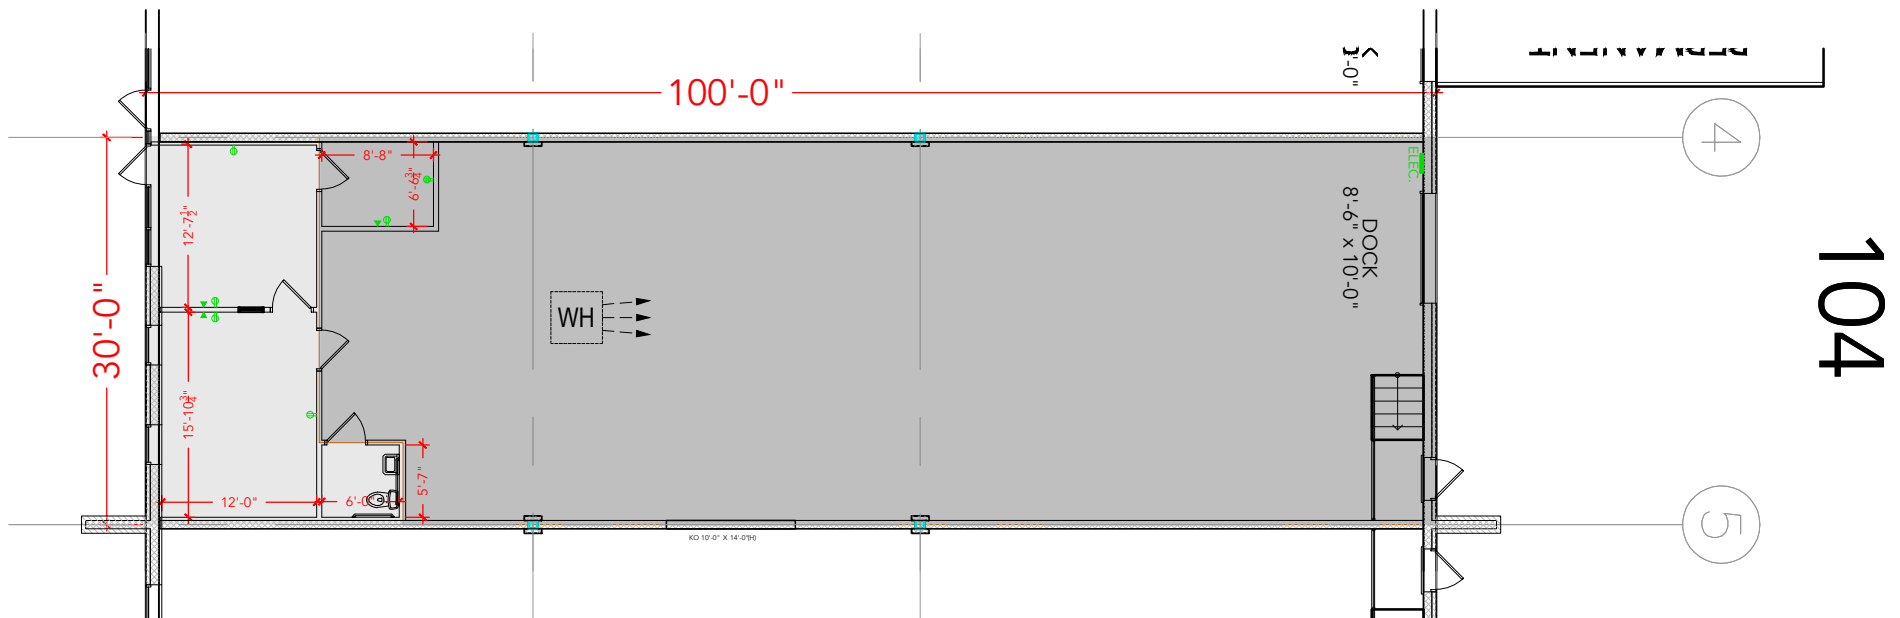

104

Floor Plan