


TOTAL SF AVAILABLE -6,600 SF


OFFICE - 471 SF

WAREHOUSE - 6,129 SF

[Click to access CADD file](#)

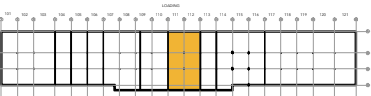

Key Plan

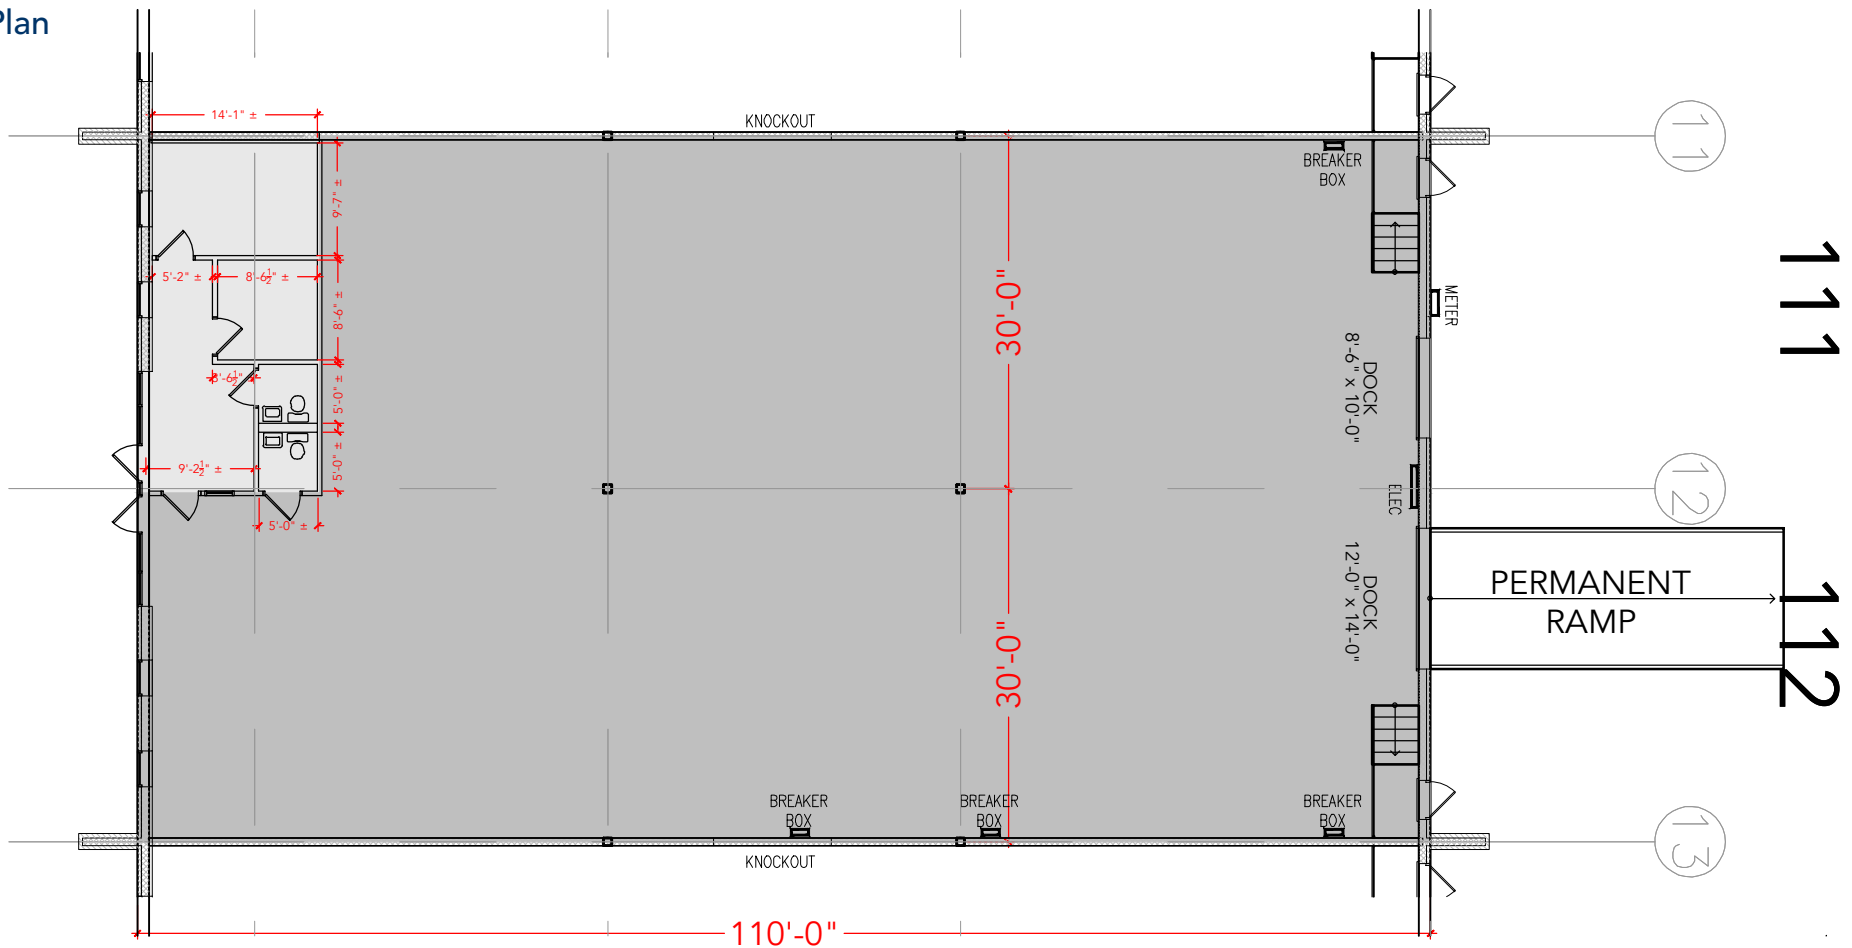

Floor Plan