


TOTAL SF AVAILABLE -3,300 SF


OFFICE - 0,000 SF

WAREHOUSE - 3,300 SF

[Click to access CADD file](#)

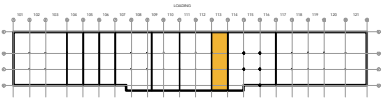

Key Plan

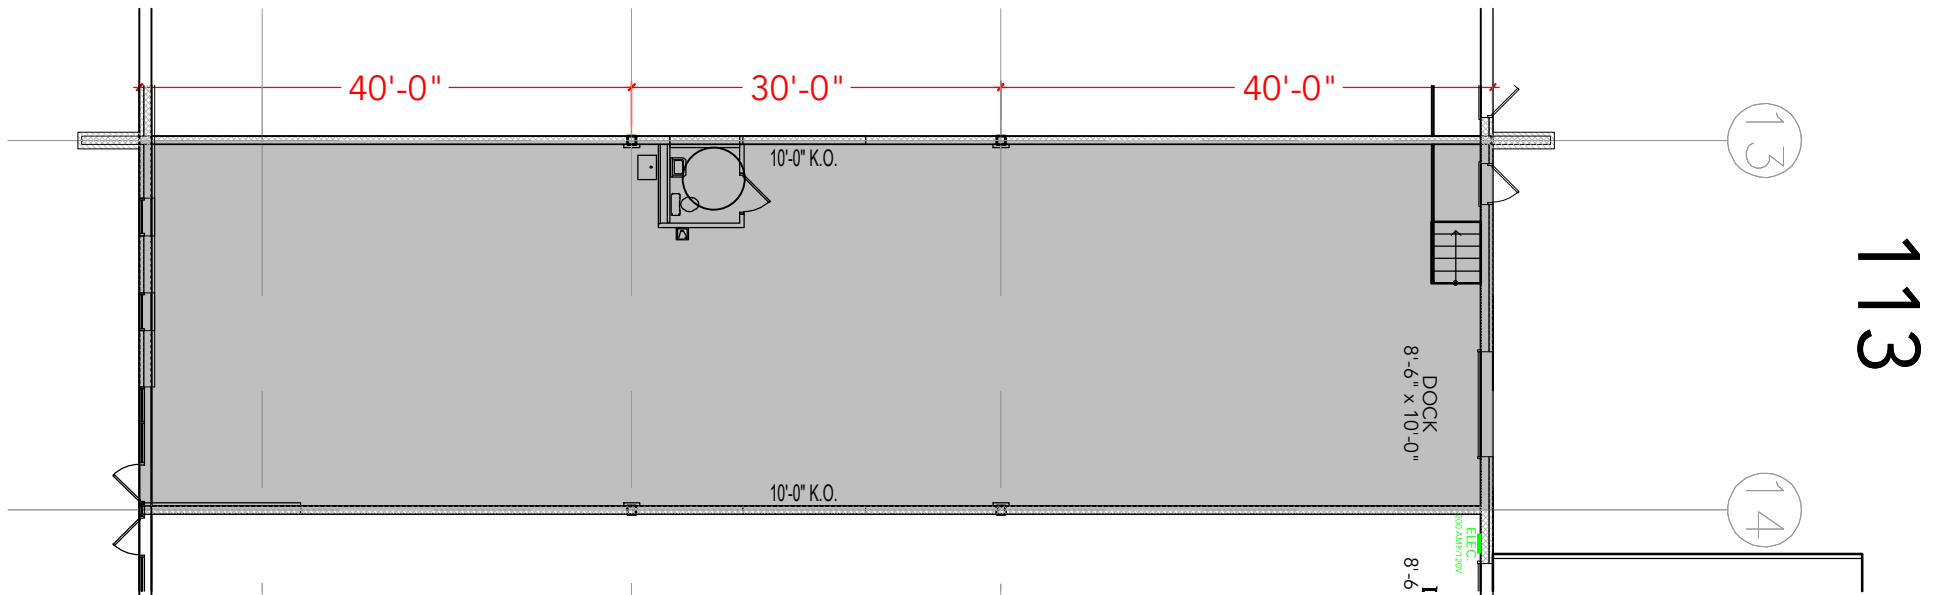

Floor Plan