


TOTAL SF AVAILABLE - 6,000 SF


OFFICE - 1,103 SF

WAREHOUSE - 4,897 SF

[Click to access 3D model](#)

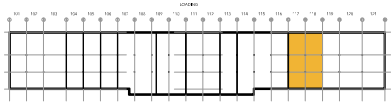

Key Plan

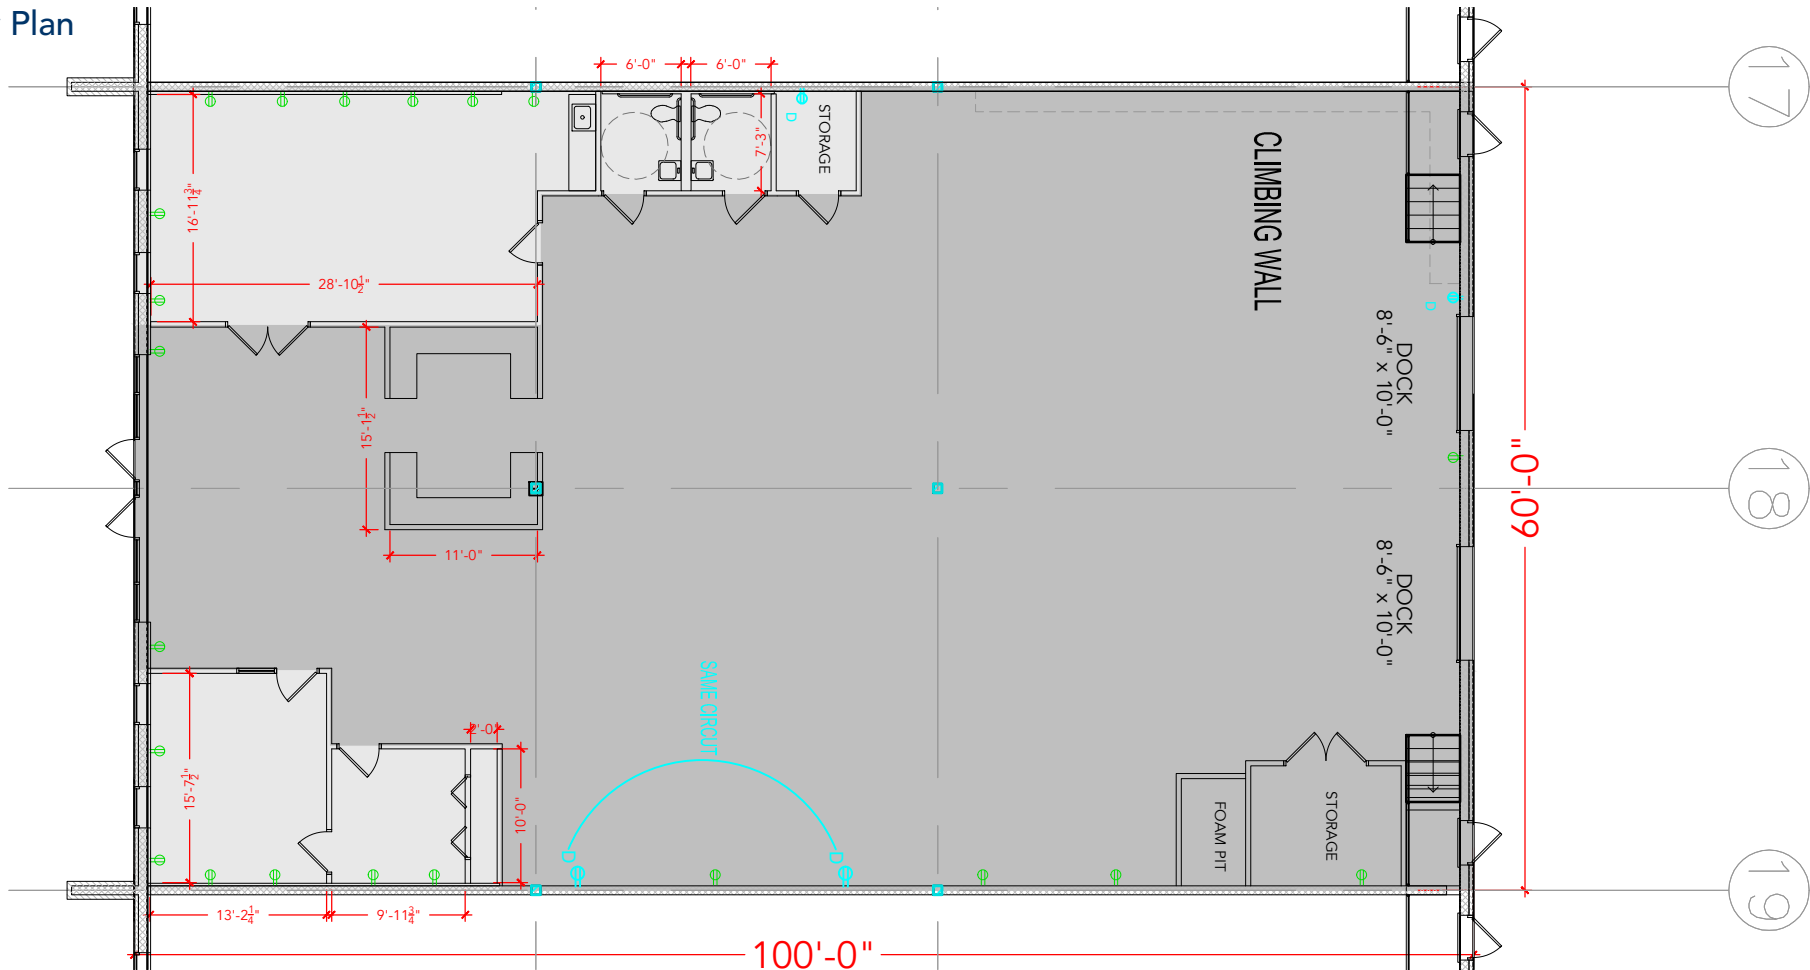

117

118

Floor Plan