


TOTAL SF AVAILABLE - 3,000 SF


OFFICE - 404 SF

WAREHOUSE - 2,596 SF

[Click to access 3D model](#)

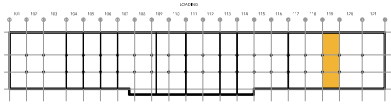

Key Plan

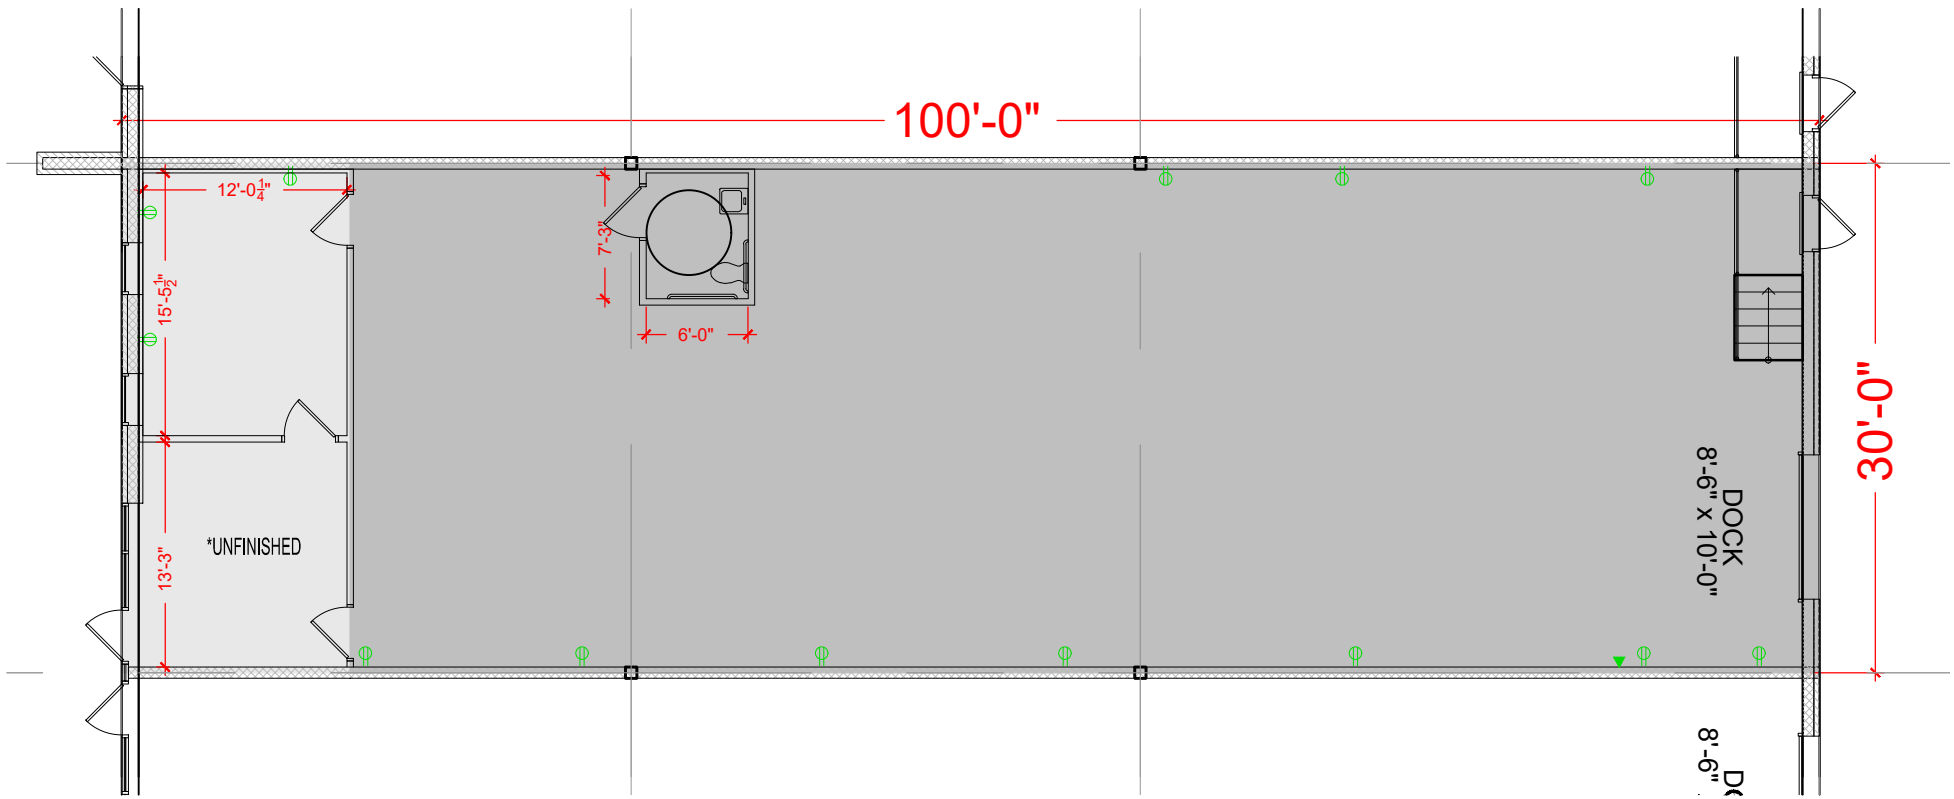

Floor Plan