


TOTAL SF AVAILABLE - 2,250 SF


OFFICE - 832 SF

WAREHOUSE SF - 1,418 SF

[Click to access 3D model](#)

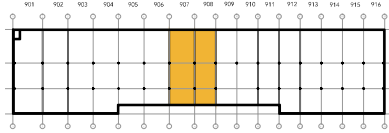

Key Plan

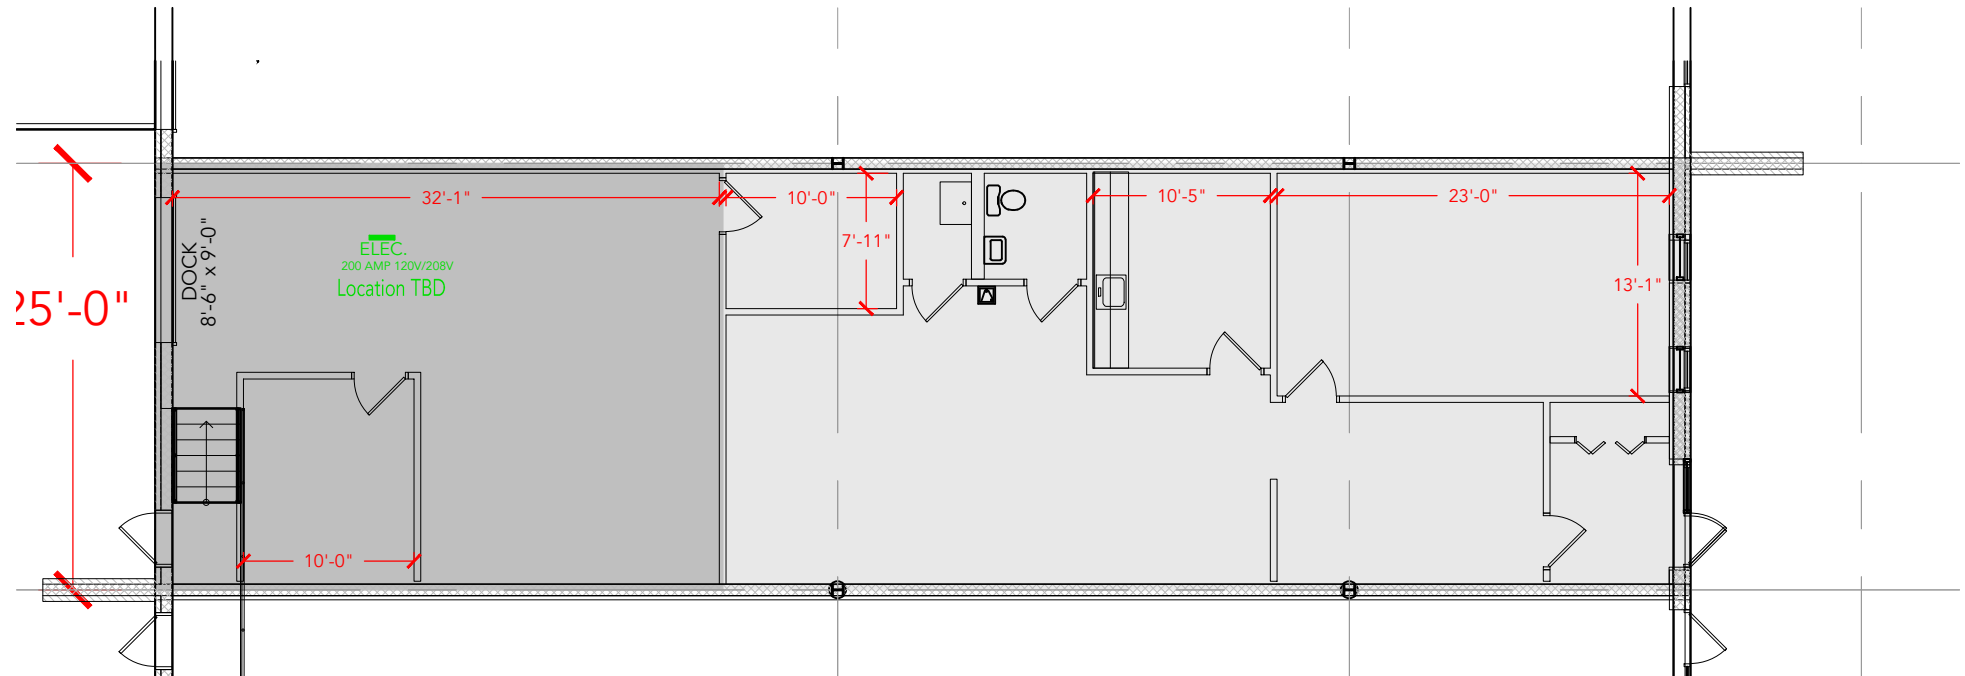

Floor Plan