



TOTAL SF AVAILABLE - 2,500 SF

OFFICE - 568 SF
WAREHOUSE SF - 1,932 SF

[Click to access 3D model](#)

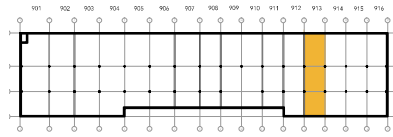

Key Plan

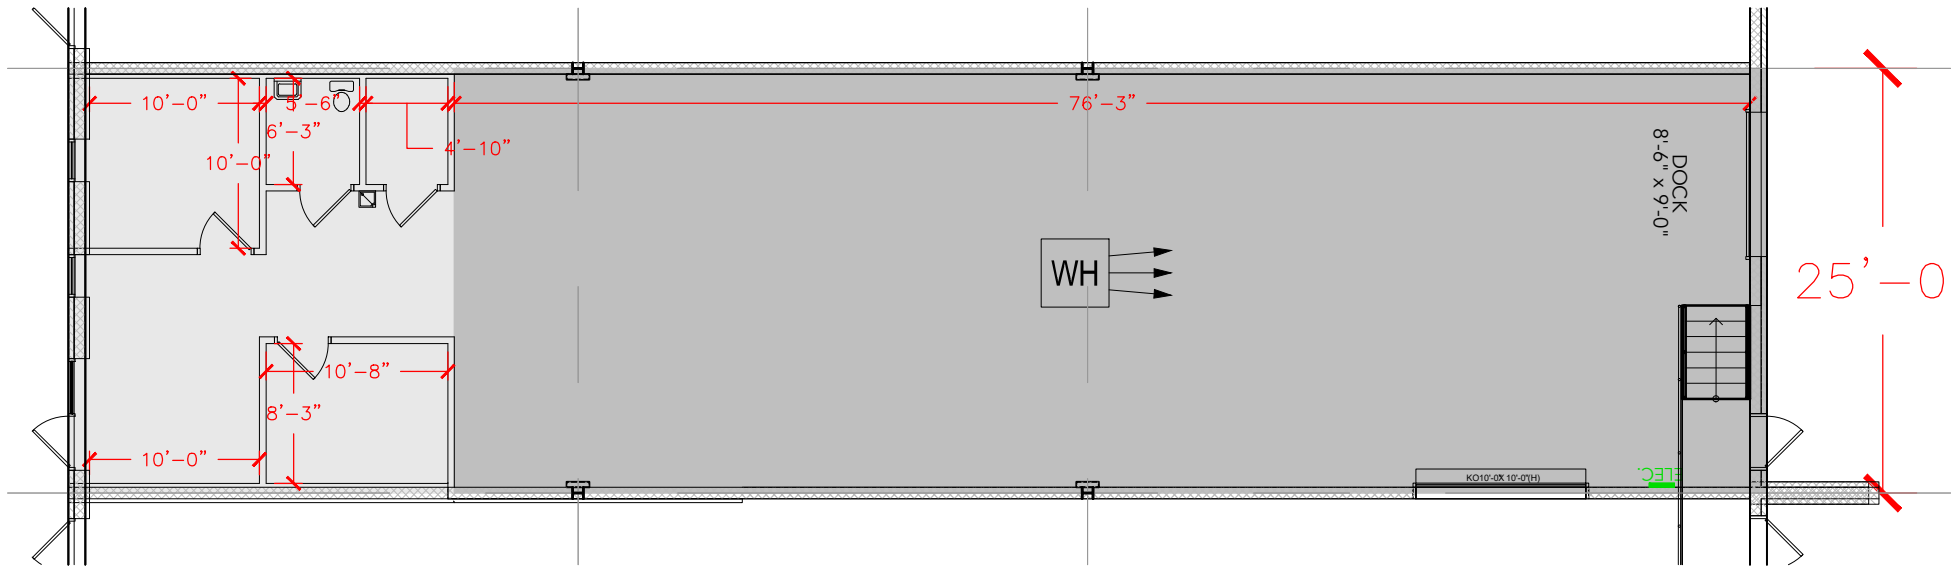

Floor Plan