


TOTAL SF AVAILABLE - 100,000 S


OFFICE - 0,000 SF

WAREHOUSE SF - 100,000 SF

[Click to access 3D model](#)

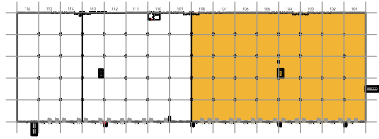

Key Plan

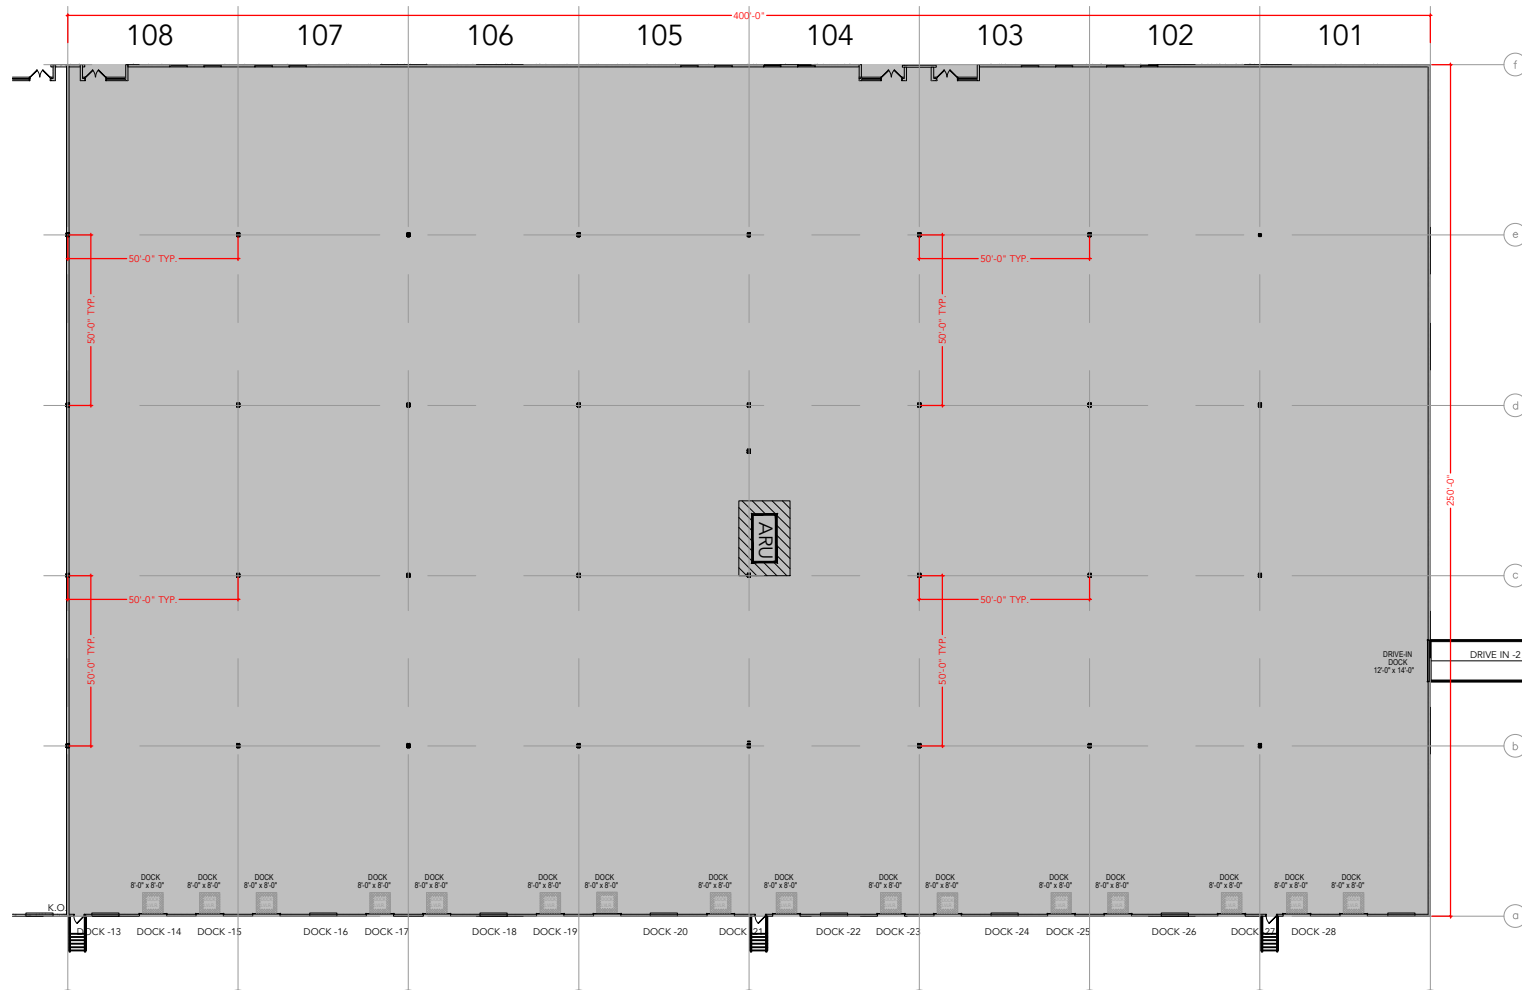

Floor Plan