


TOTAL SF AVAILABLE - 100,000 S


OFFICE - 362 SF

WAREHOUSE SF - 99,638 SF

[Click to access 3D model](#)

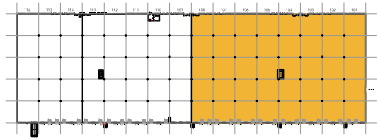

Key Plan

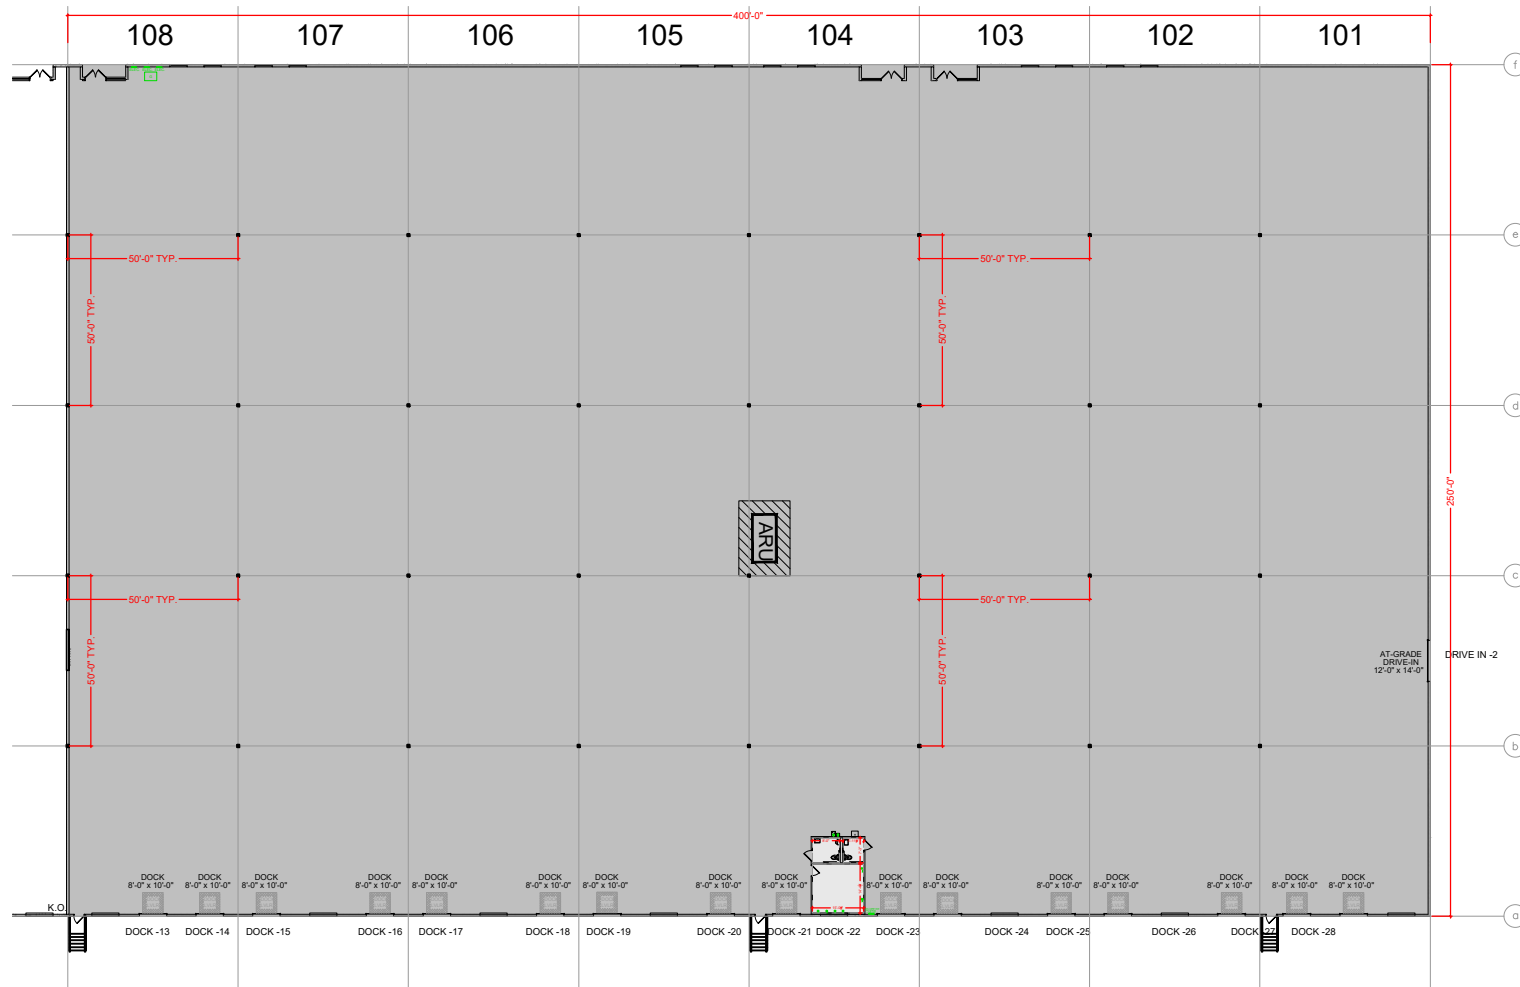

Floor Plan