


TOTAL SF AVAILABLE -100,208 RSF

OFFICE - 363 RSF


WAREHOUSE - 99,845 RSF

* INCLUDES % OF METER ROOM

[Click to access 3D model](#)

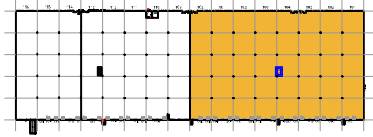

Key Plan

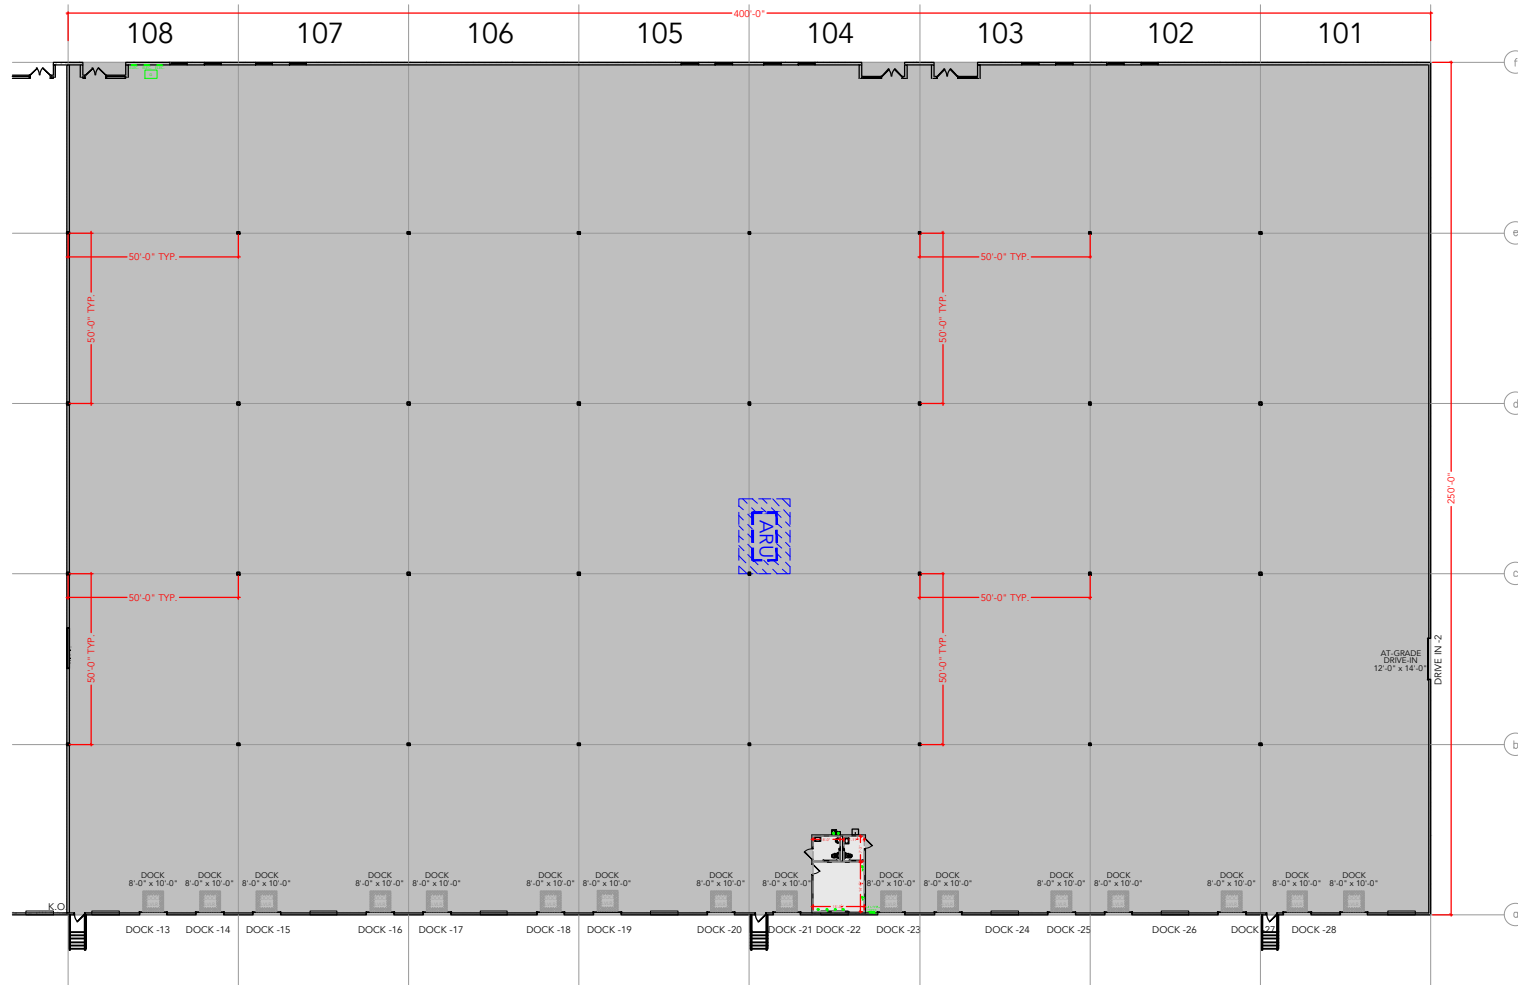

Floor Plan