


TOTAL SF AVAILABLE - 20,000 SF

OFFICE - 20,000 SF

WAREHOUSE - 0,000 SF

[Click to access 3D model](#)

Key Plan

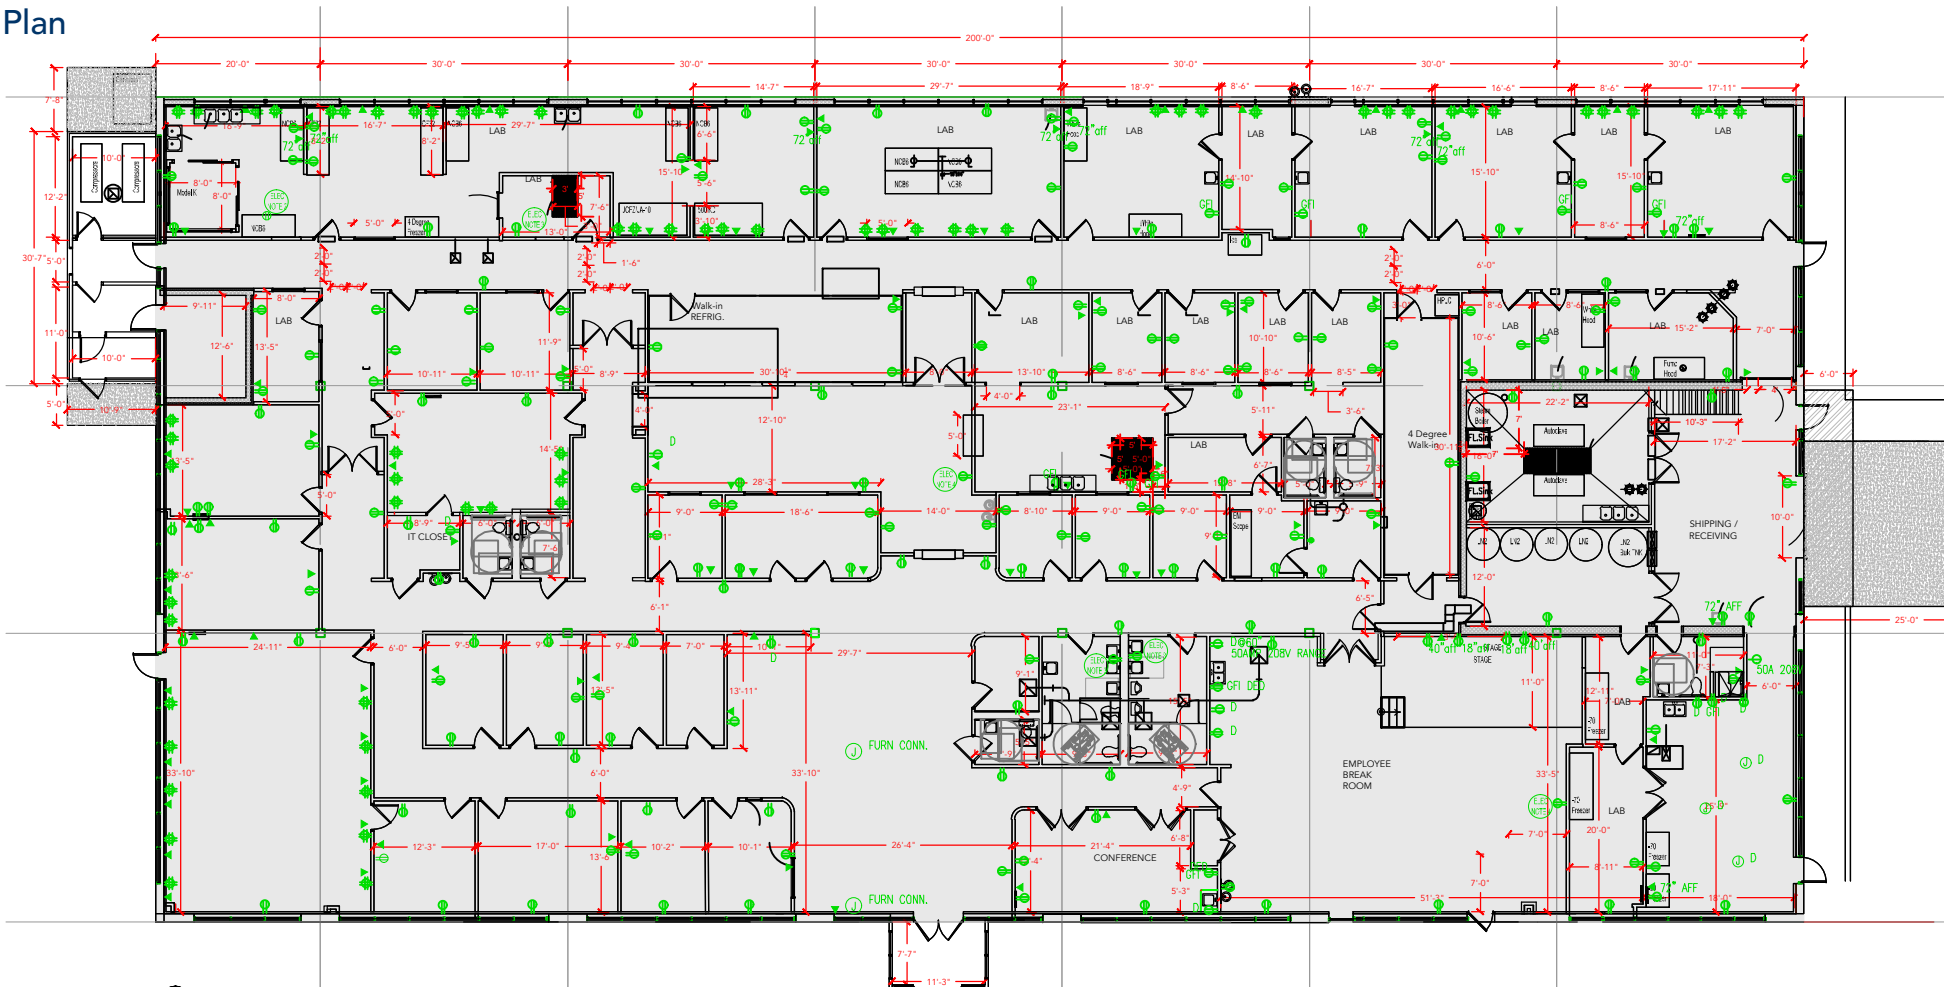

Floor Plan