


**TOTAL SF AVAILABLE - 20,000 SF**


**OFFICE - 12,868 SF**

**WAREHOUSE - 7,132 SF**

[Click to access 3D model](#)

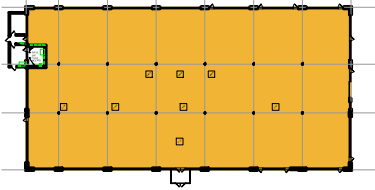

Key Plan

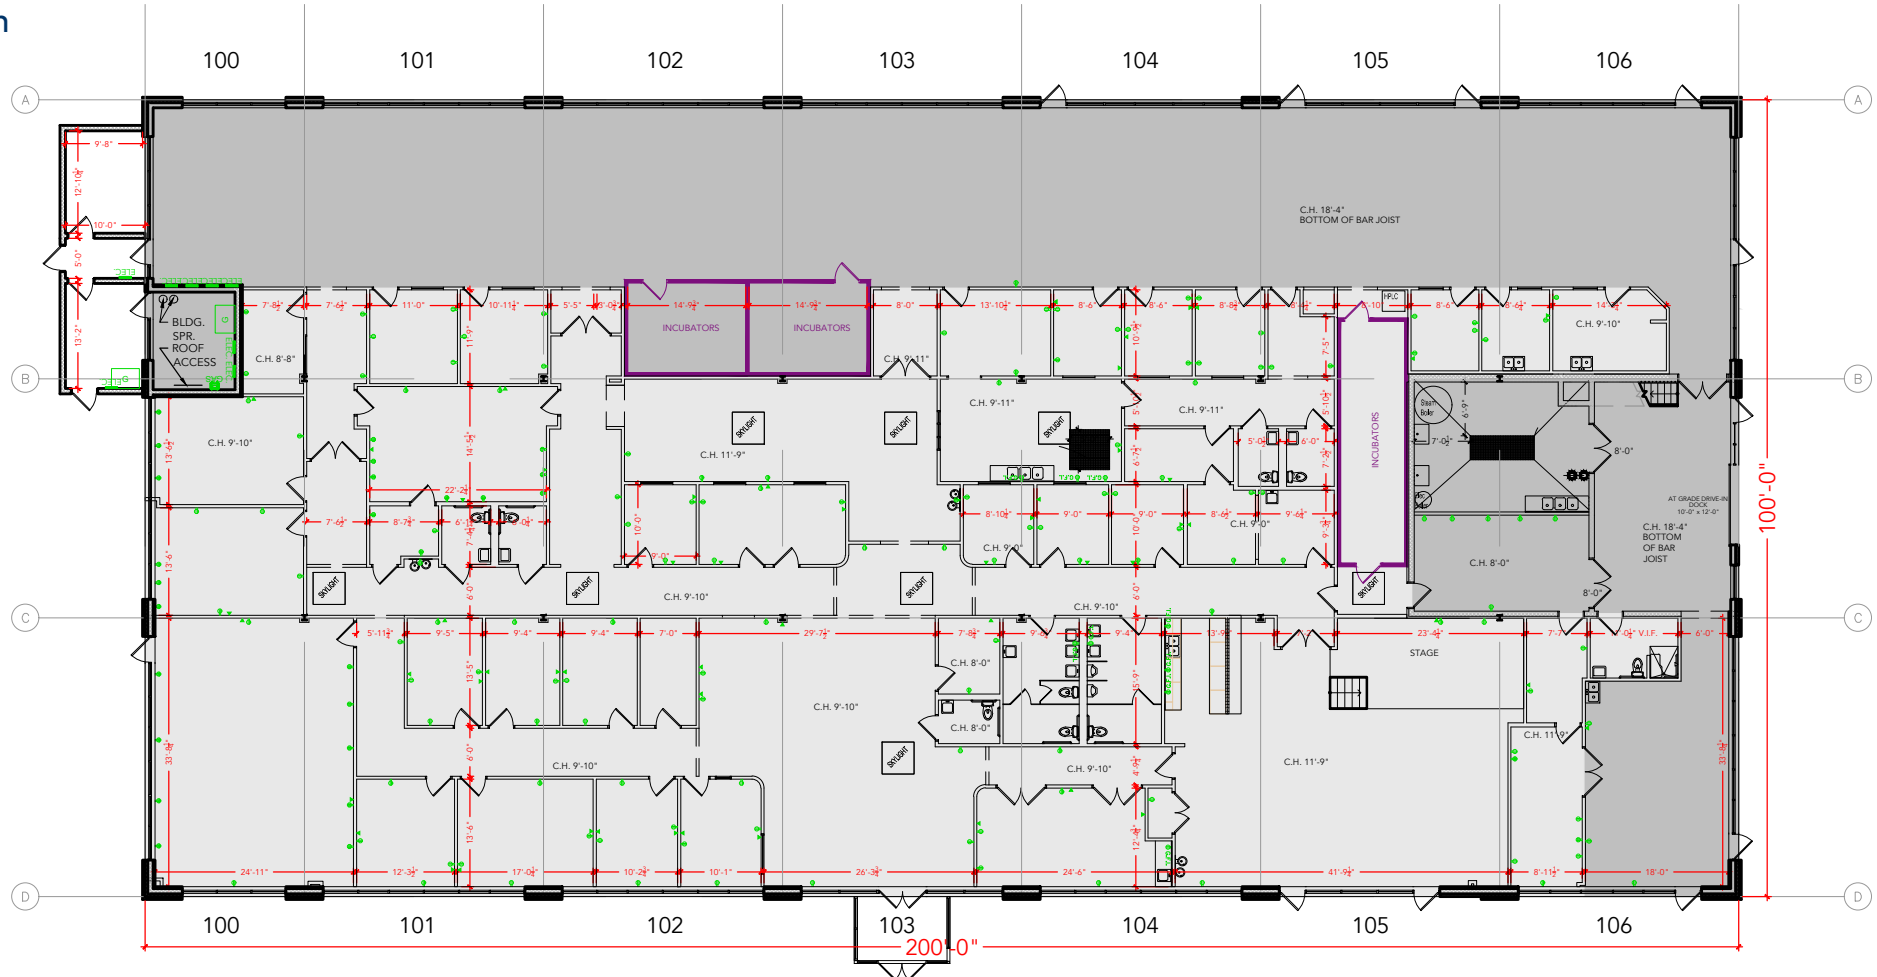

Floor Plan