


TOTAL SF AVAILABLE - 1,615 RSF(12.6%)

Key Plan

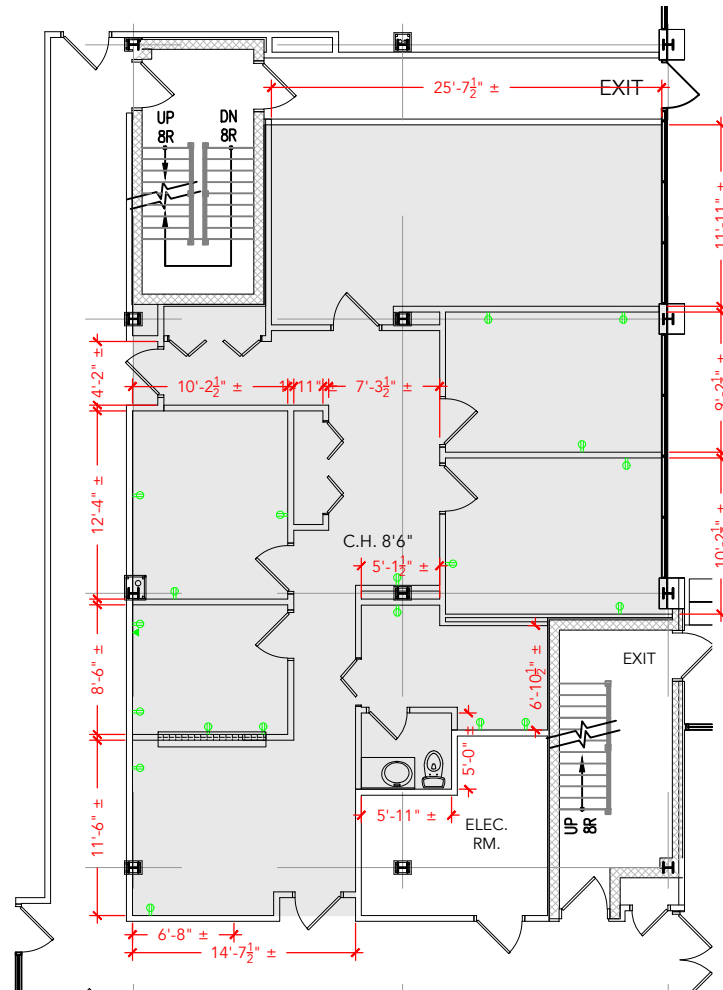

Floor Plan