



TOTAL SF AVAILABLE -752 RSF (12.6%)

[Click to access CADD file](#)

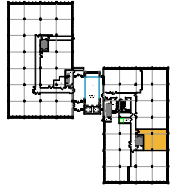

Key Plan

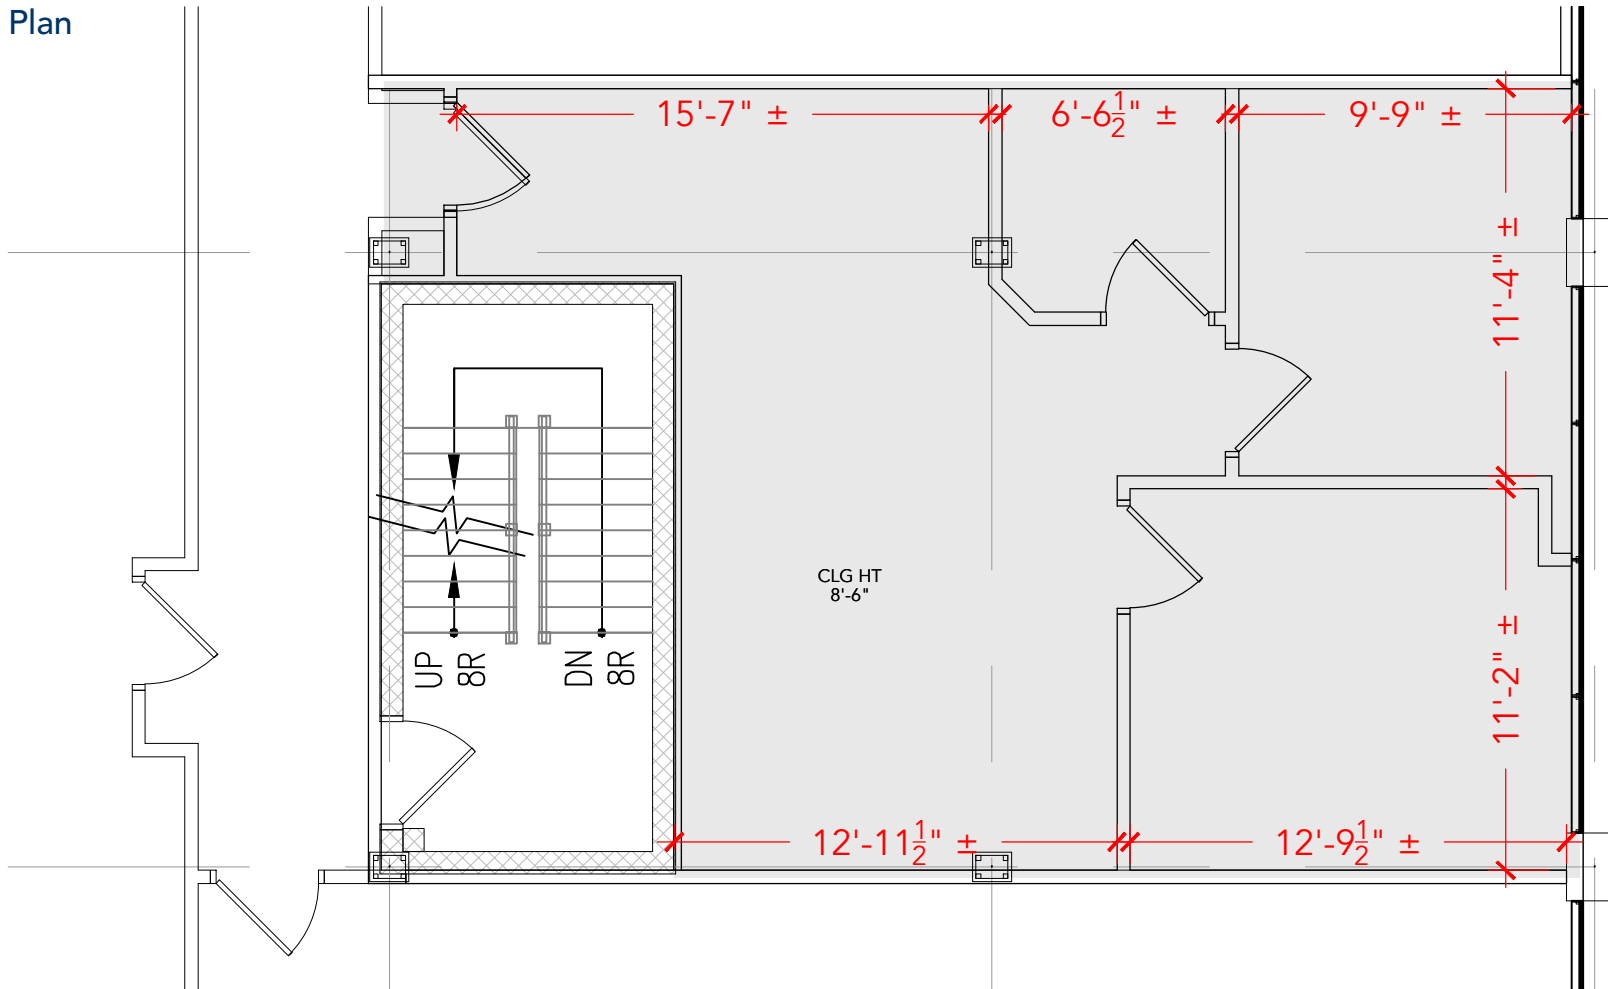

Floor Plan